


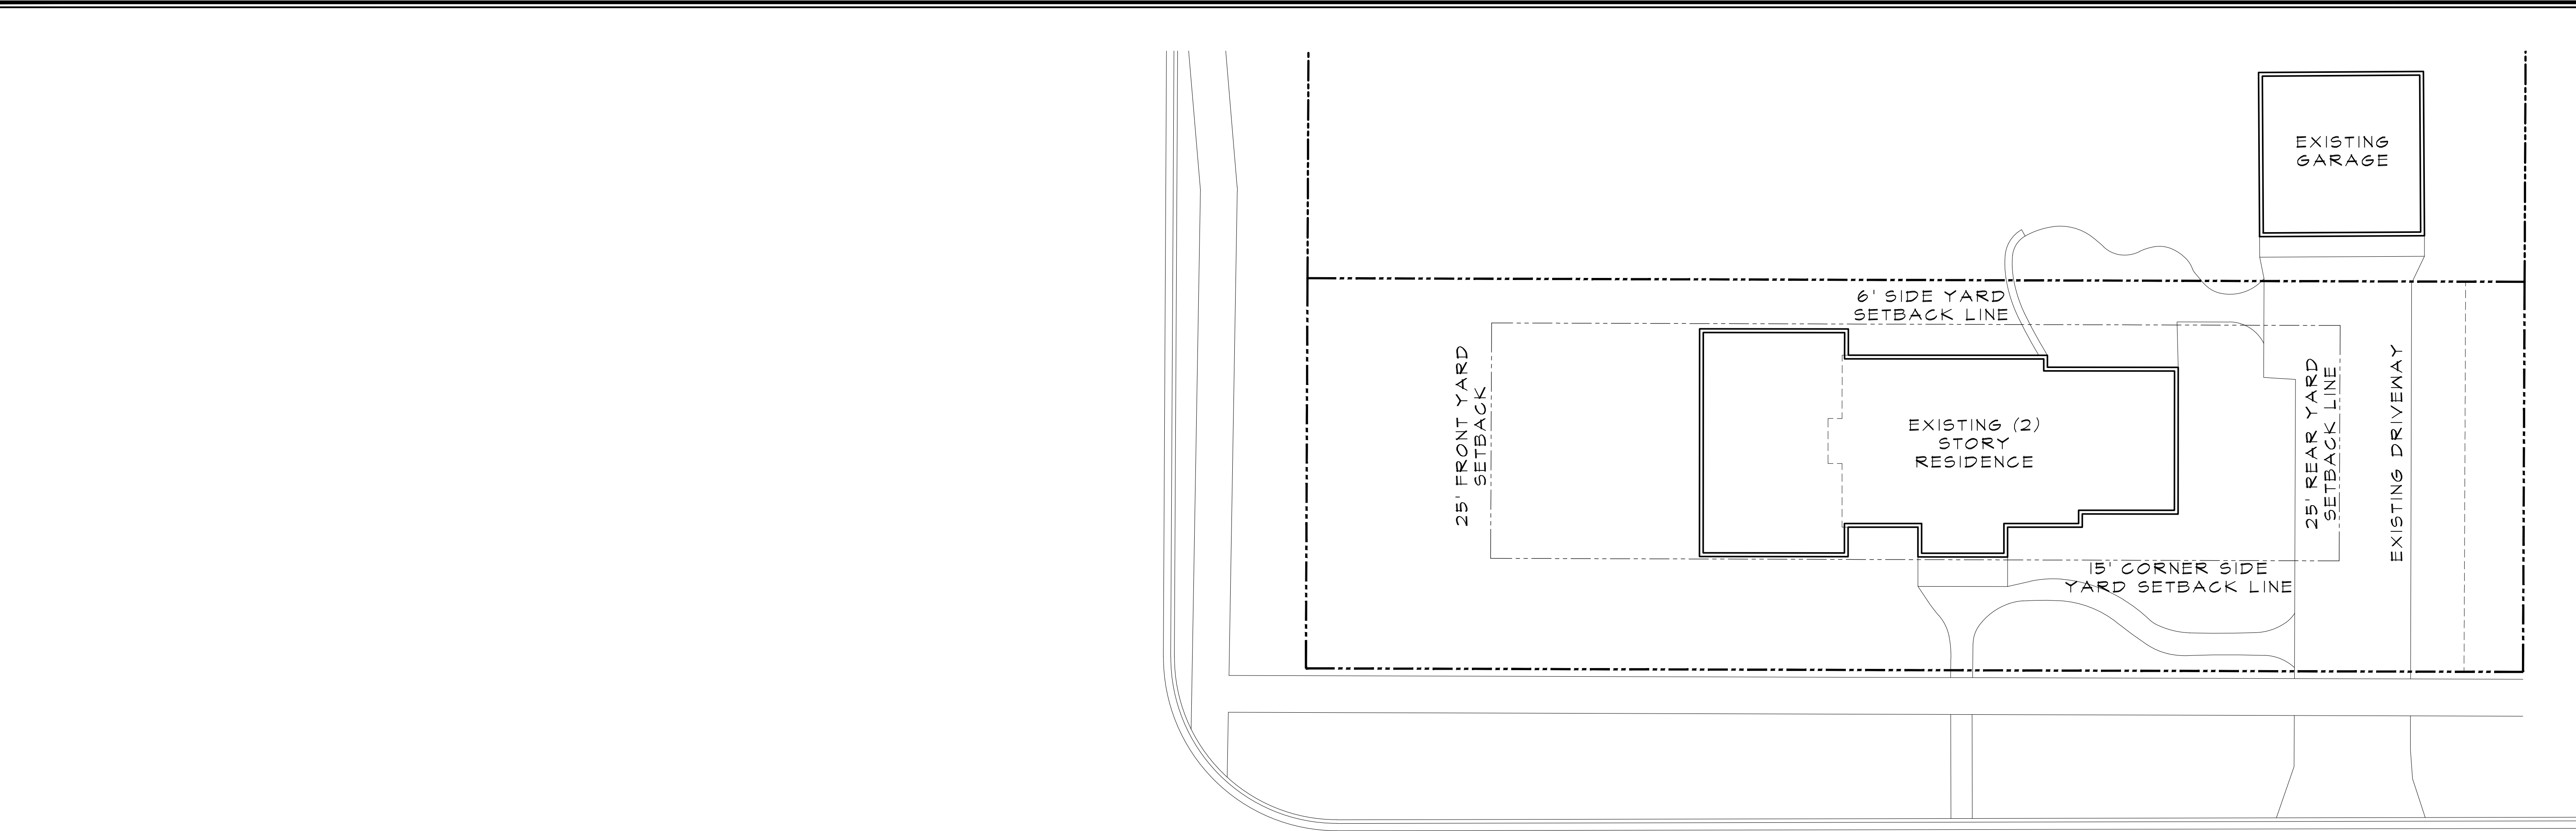


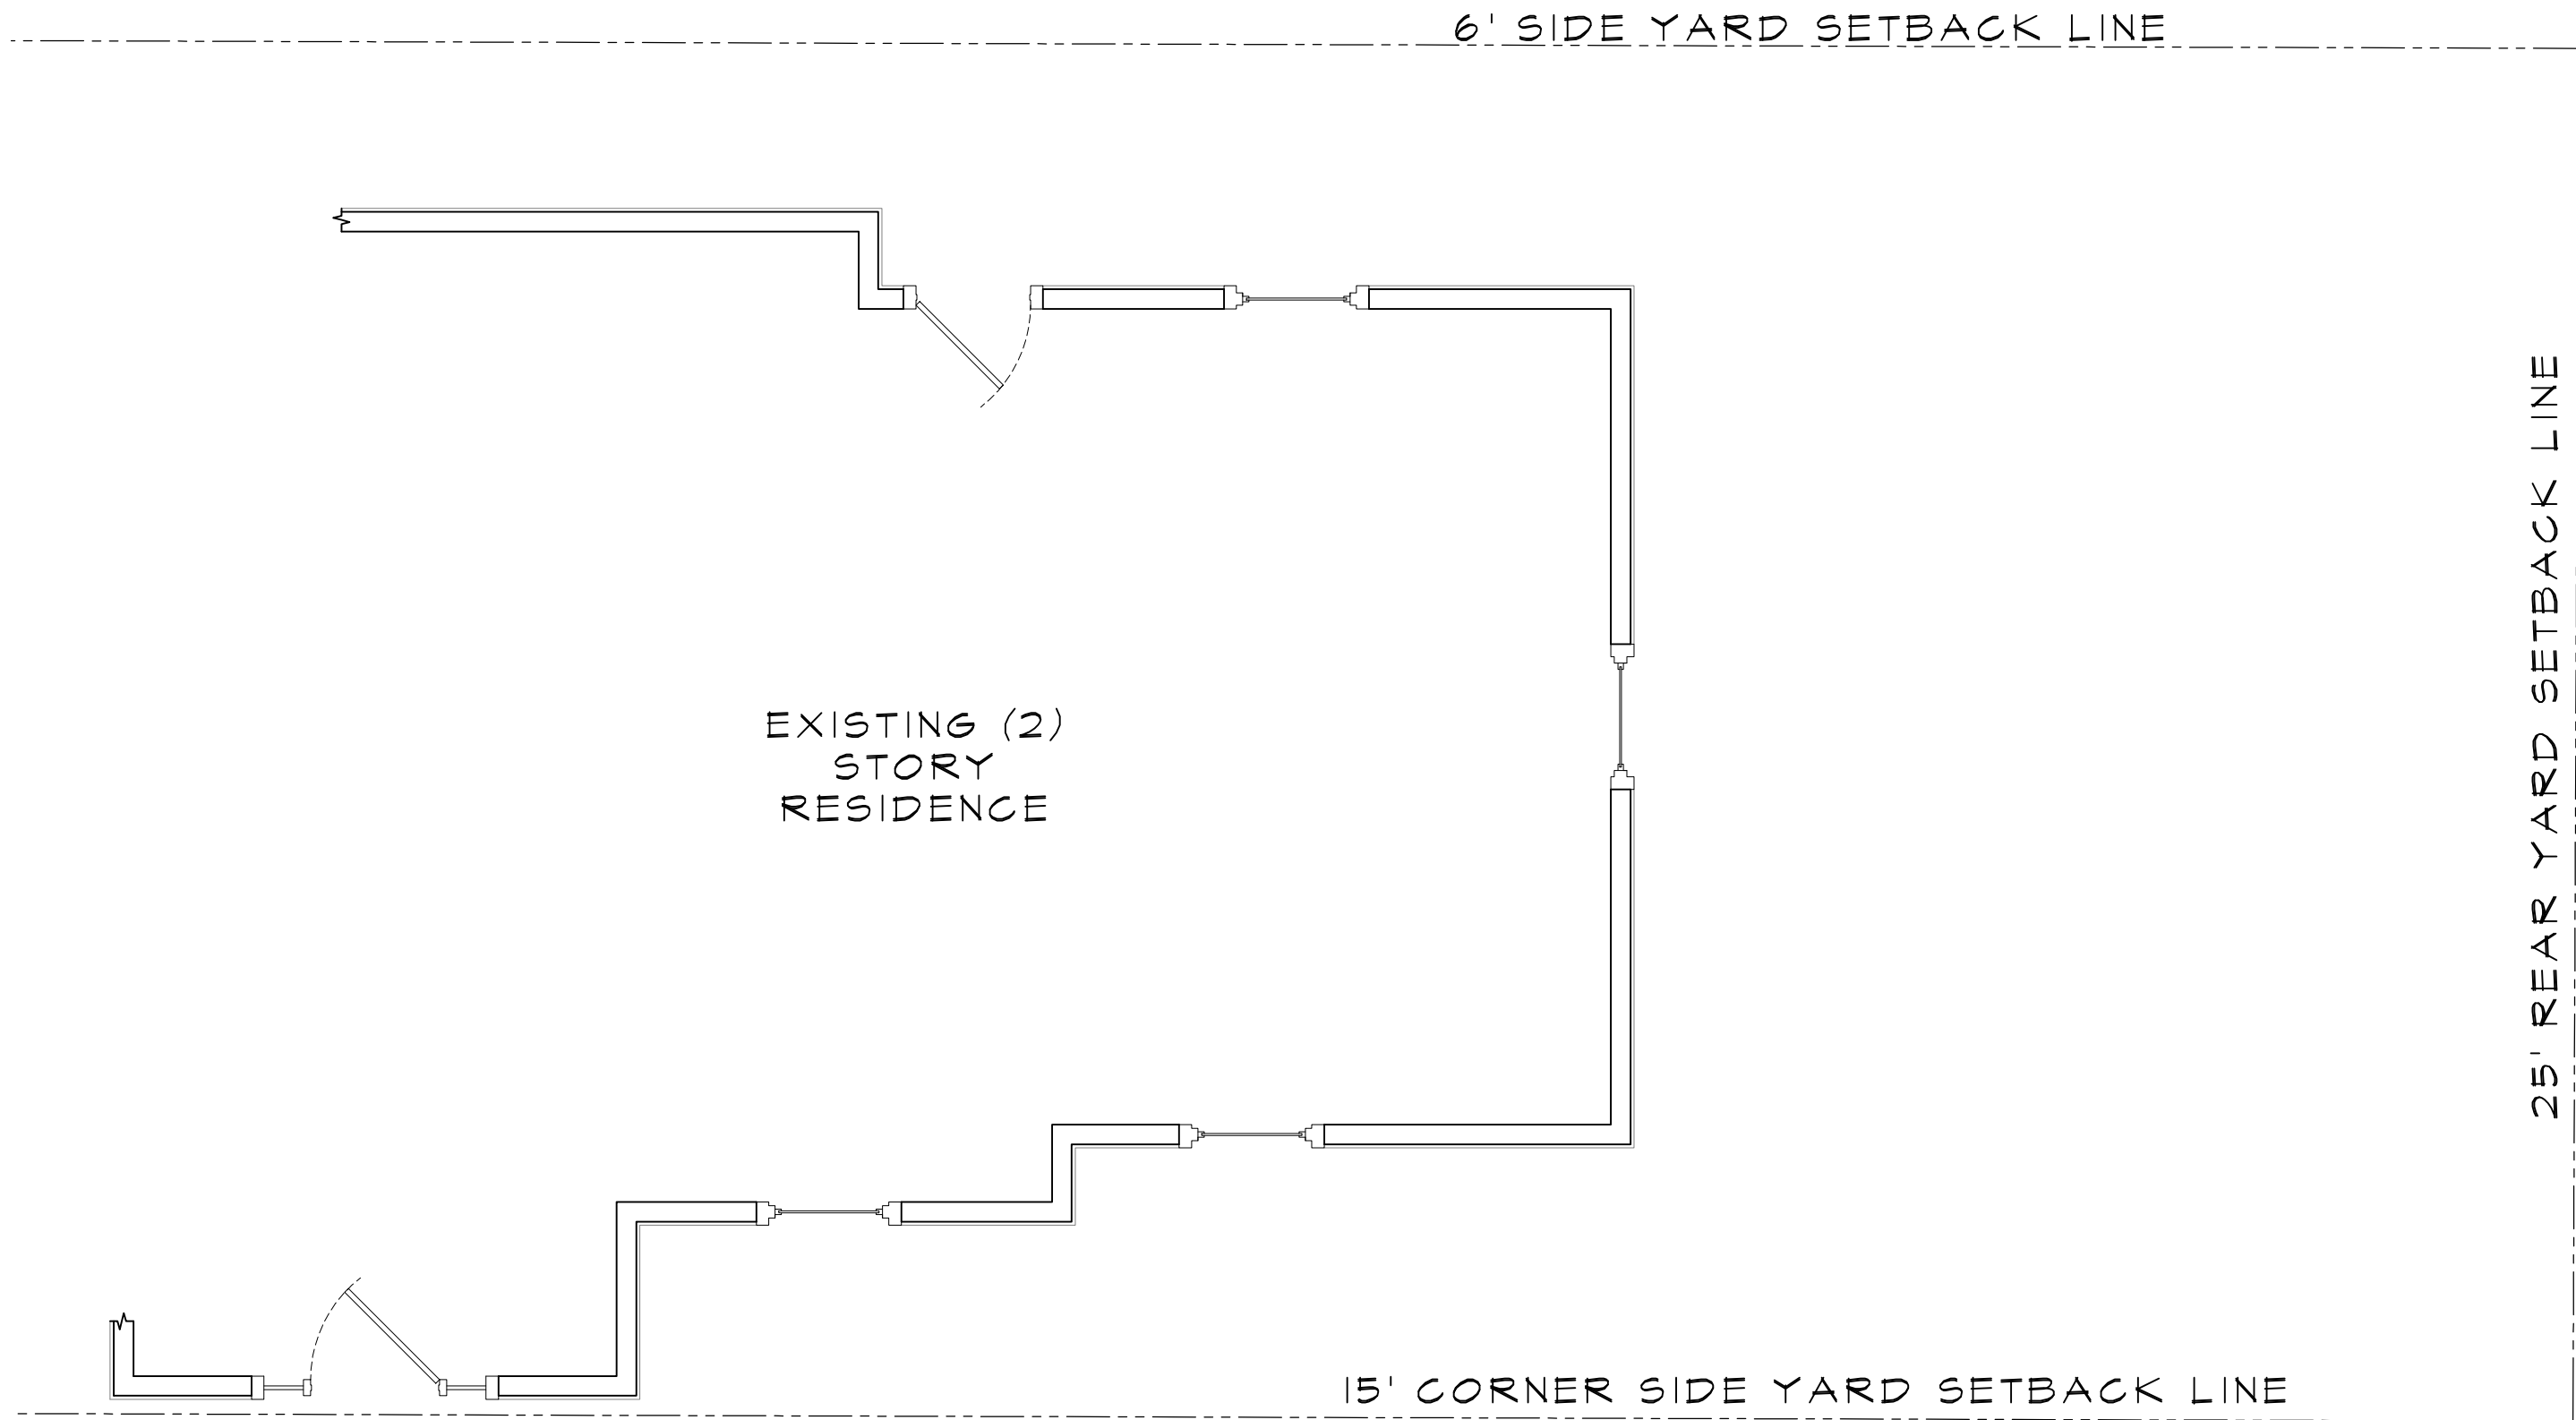

SITE PLAN
SCALE: 3/32" = 1'-0"

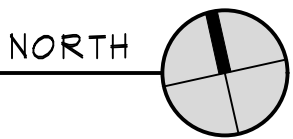

PARTIAL FIRST FLOOR PLAN
SCALE: 1/4" = 1'-0"

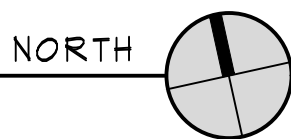

**EXISTING
CONDITIONS**

MAY RESIDENCE
693 COTTAGE AVENUE
NAPERVILLE, ILLINOIS

Project 25-112
AS-BUILT
DRAWING



Date 8-15-25

SHEET 1 OF 1

Revisions

ASBLT