


**LEGAL PROPERTY DESCRIPTION:**  
THE SOUTH HALF OF LOT 2 AND THE NORTH HALF OF LOT 3 IN BLOCK 1 IN SLEIGHT'S ORCHARD ADDITION TO THE CITY OF NAPERVILLE, BEING A SUBDIVISION IN SECTION 18, TOWNSHIP 38 NORTH, RANGE 10 EAST OF THE THIRD PRINCIPAL MERIDIAN, ACCORDING TO THE PLAT THEREOF RECORDED OCTOBER 23, 1905 AS DOCUMENT 85886, IN DUPAGE COUNTY, ILLINOIS.

**POST OFFICE ADDRESS:**  
218 N. COLUMBIA STREET, NAPERVILLE, ILLINOIS



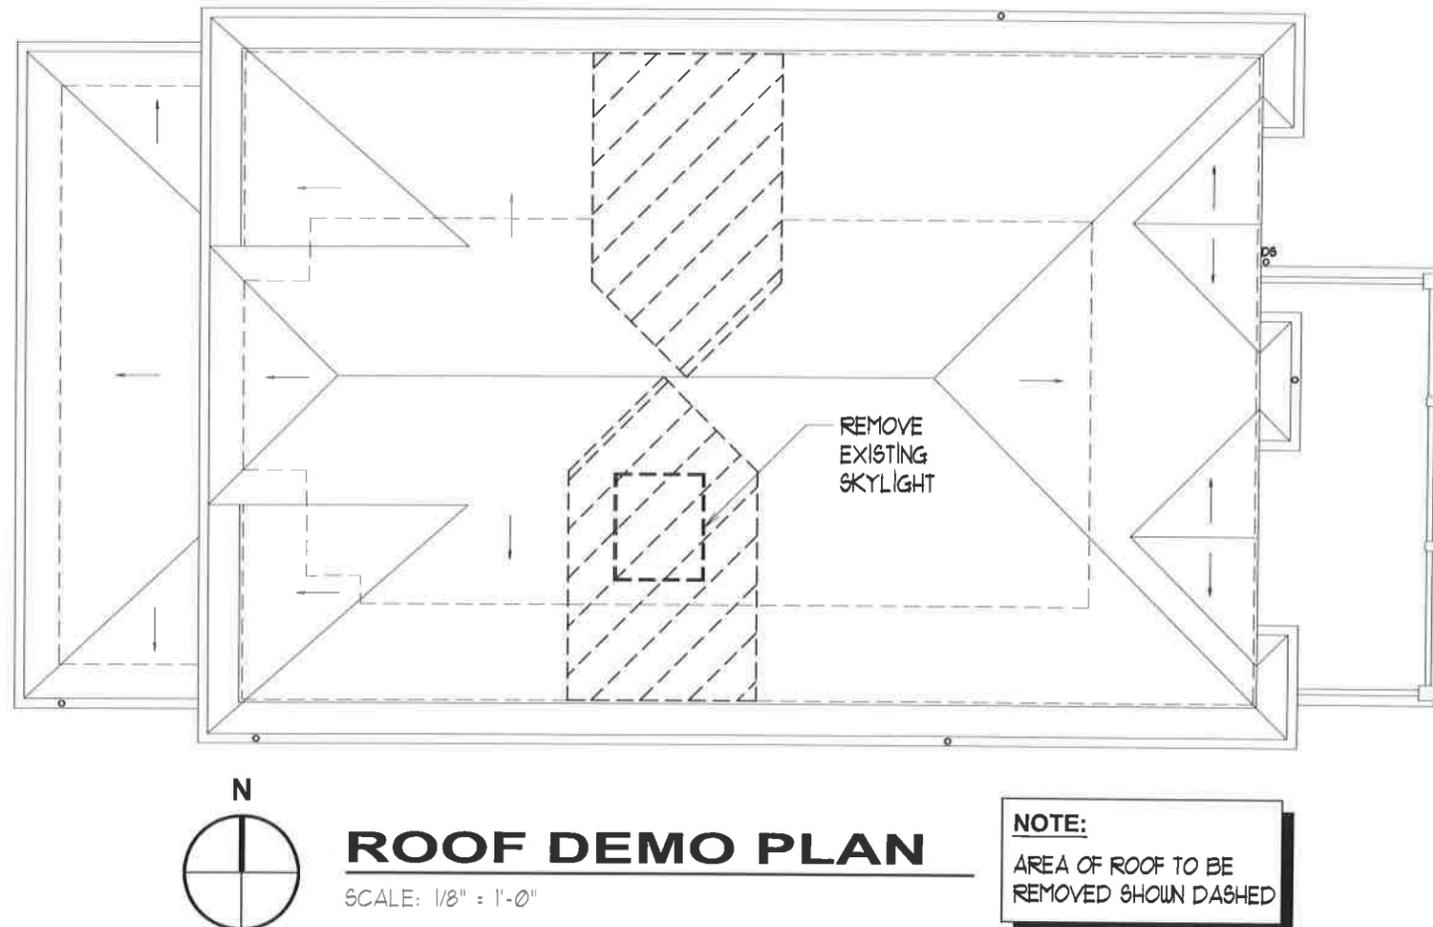

Existing dormer to remain. New side dormers to match existing dormer's roof details and materials. Siding to be replaced by new ~~composite~~ **WOOD** siding to match existing style.

New shutters at existing windows.

New ~~composite~~ **WOOD** siding throughout the house besides existing porch.

New ~~cedar~~ **POLYURETHANE** brackets under existing porch and main roof eaves.



New bracket profile

New front door style

New shutter style



Existing base and vertical lattice to be ~~replaced~~ and block to be repaired at porch base. **REPAIRED**



Existing stairs and railing system to be replaced.



Example of similar project done in the same street.

New carpenter built composite stairs with new newel posts and railing system.



New composite base and vertical lattice.

Existing porch to remain and be painted.

New front door and shutters at existing window.

**\* TOP (5) WINDOWS TO BE REPLACED BY FIBERGLASS OR VINYL TO MATCH EXISTING**




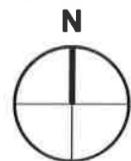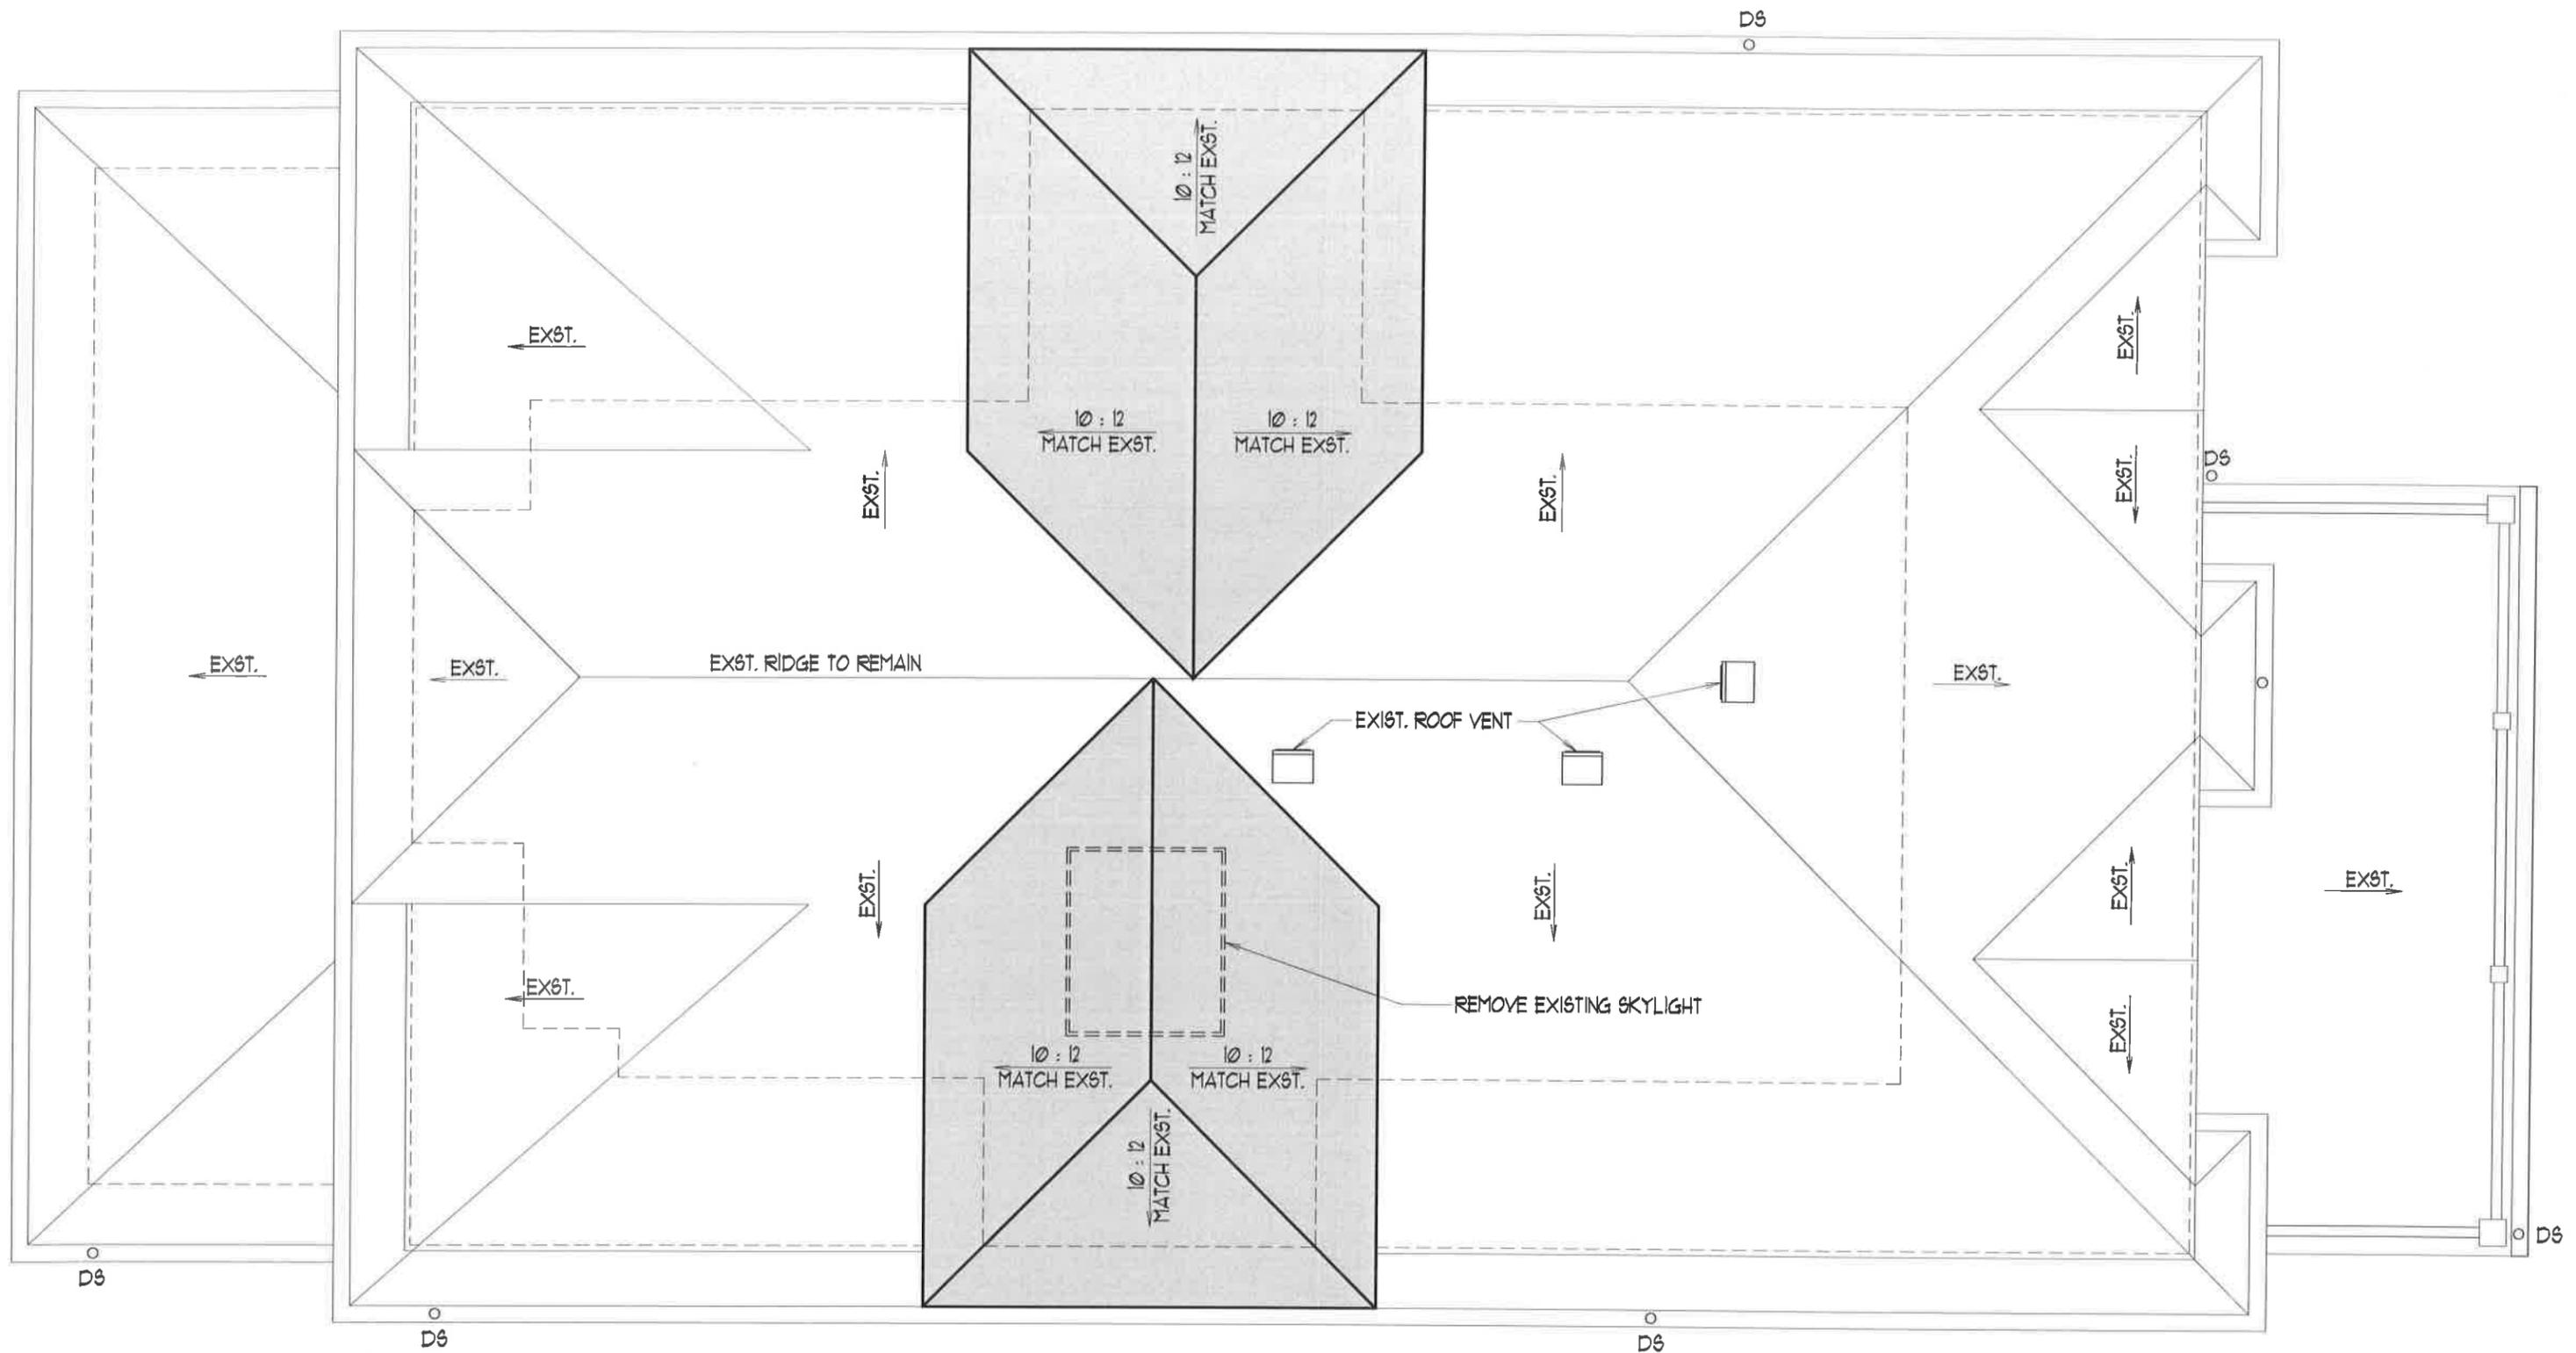

# ROOF PLAN

SCALE: 1/4" = 1'-0"

- EXISTING ROOF
- NEW ROOF
- D6 EXISTING DOWNSPOUT

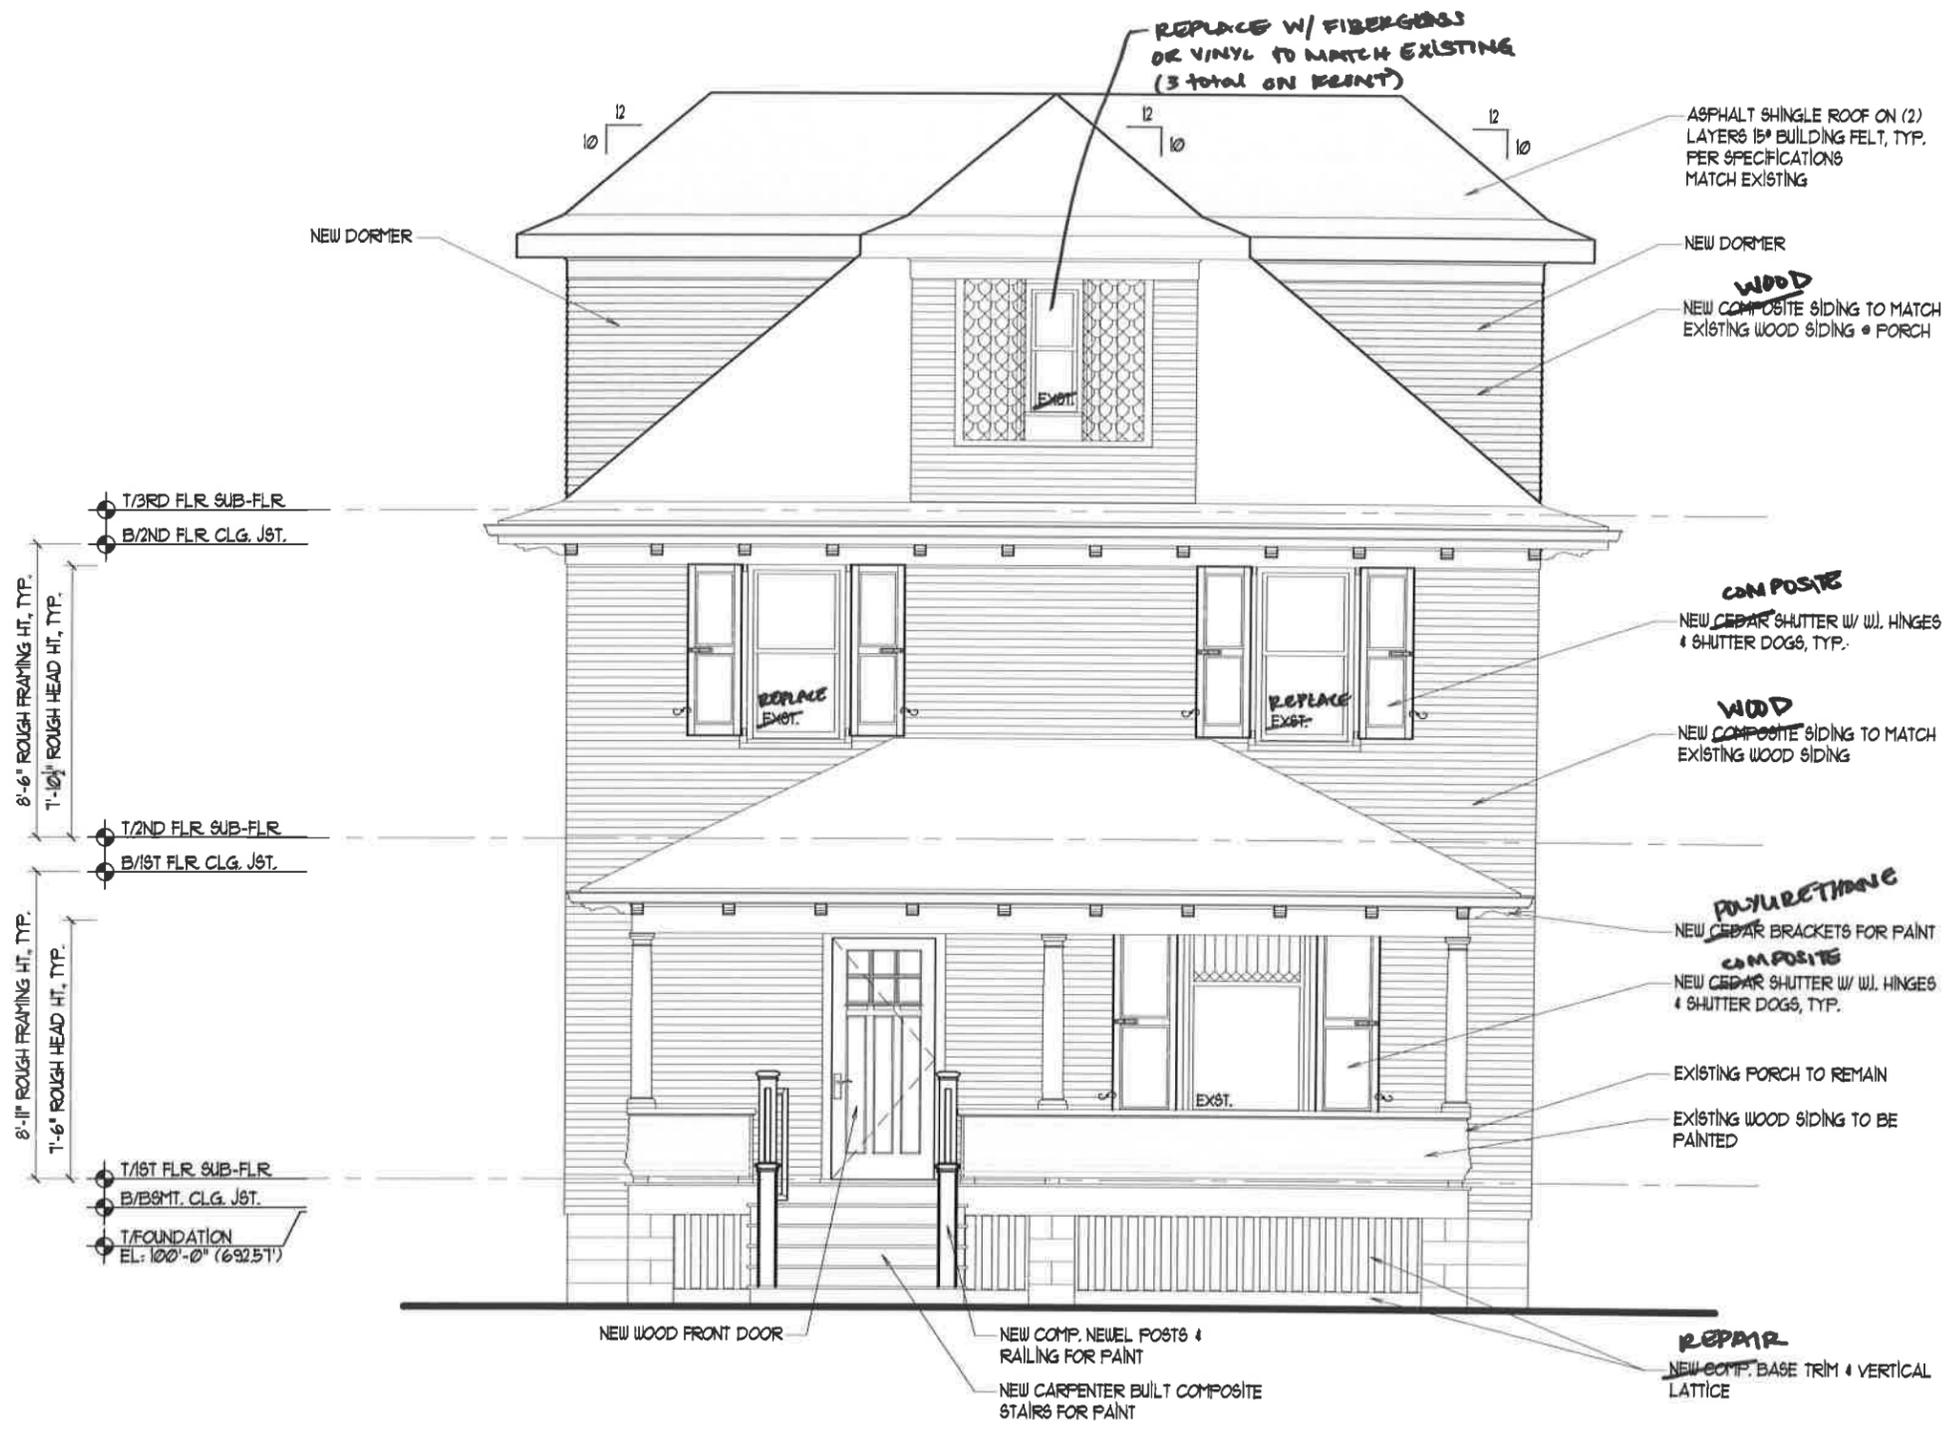


1

# WEST ELEVATION

SCALE: 3/16" = 1'-0"

**NOTE:**  
NEW DORMERS SHADED FOR CLARITY

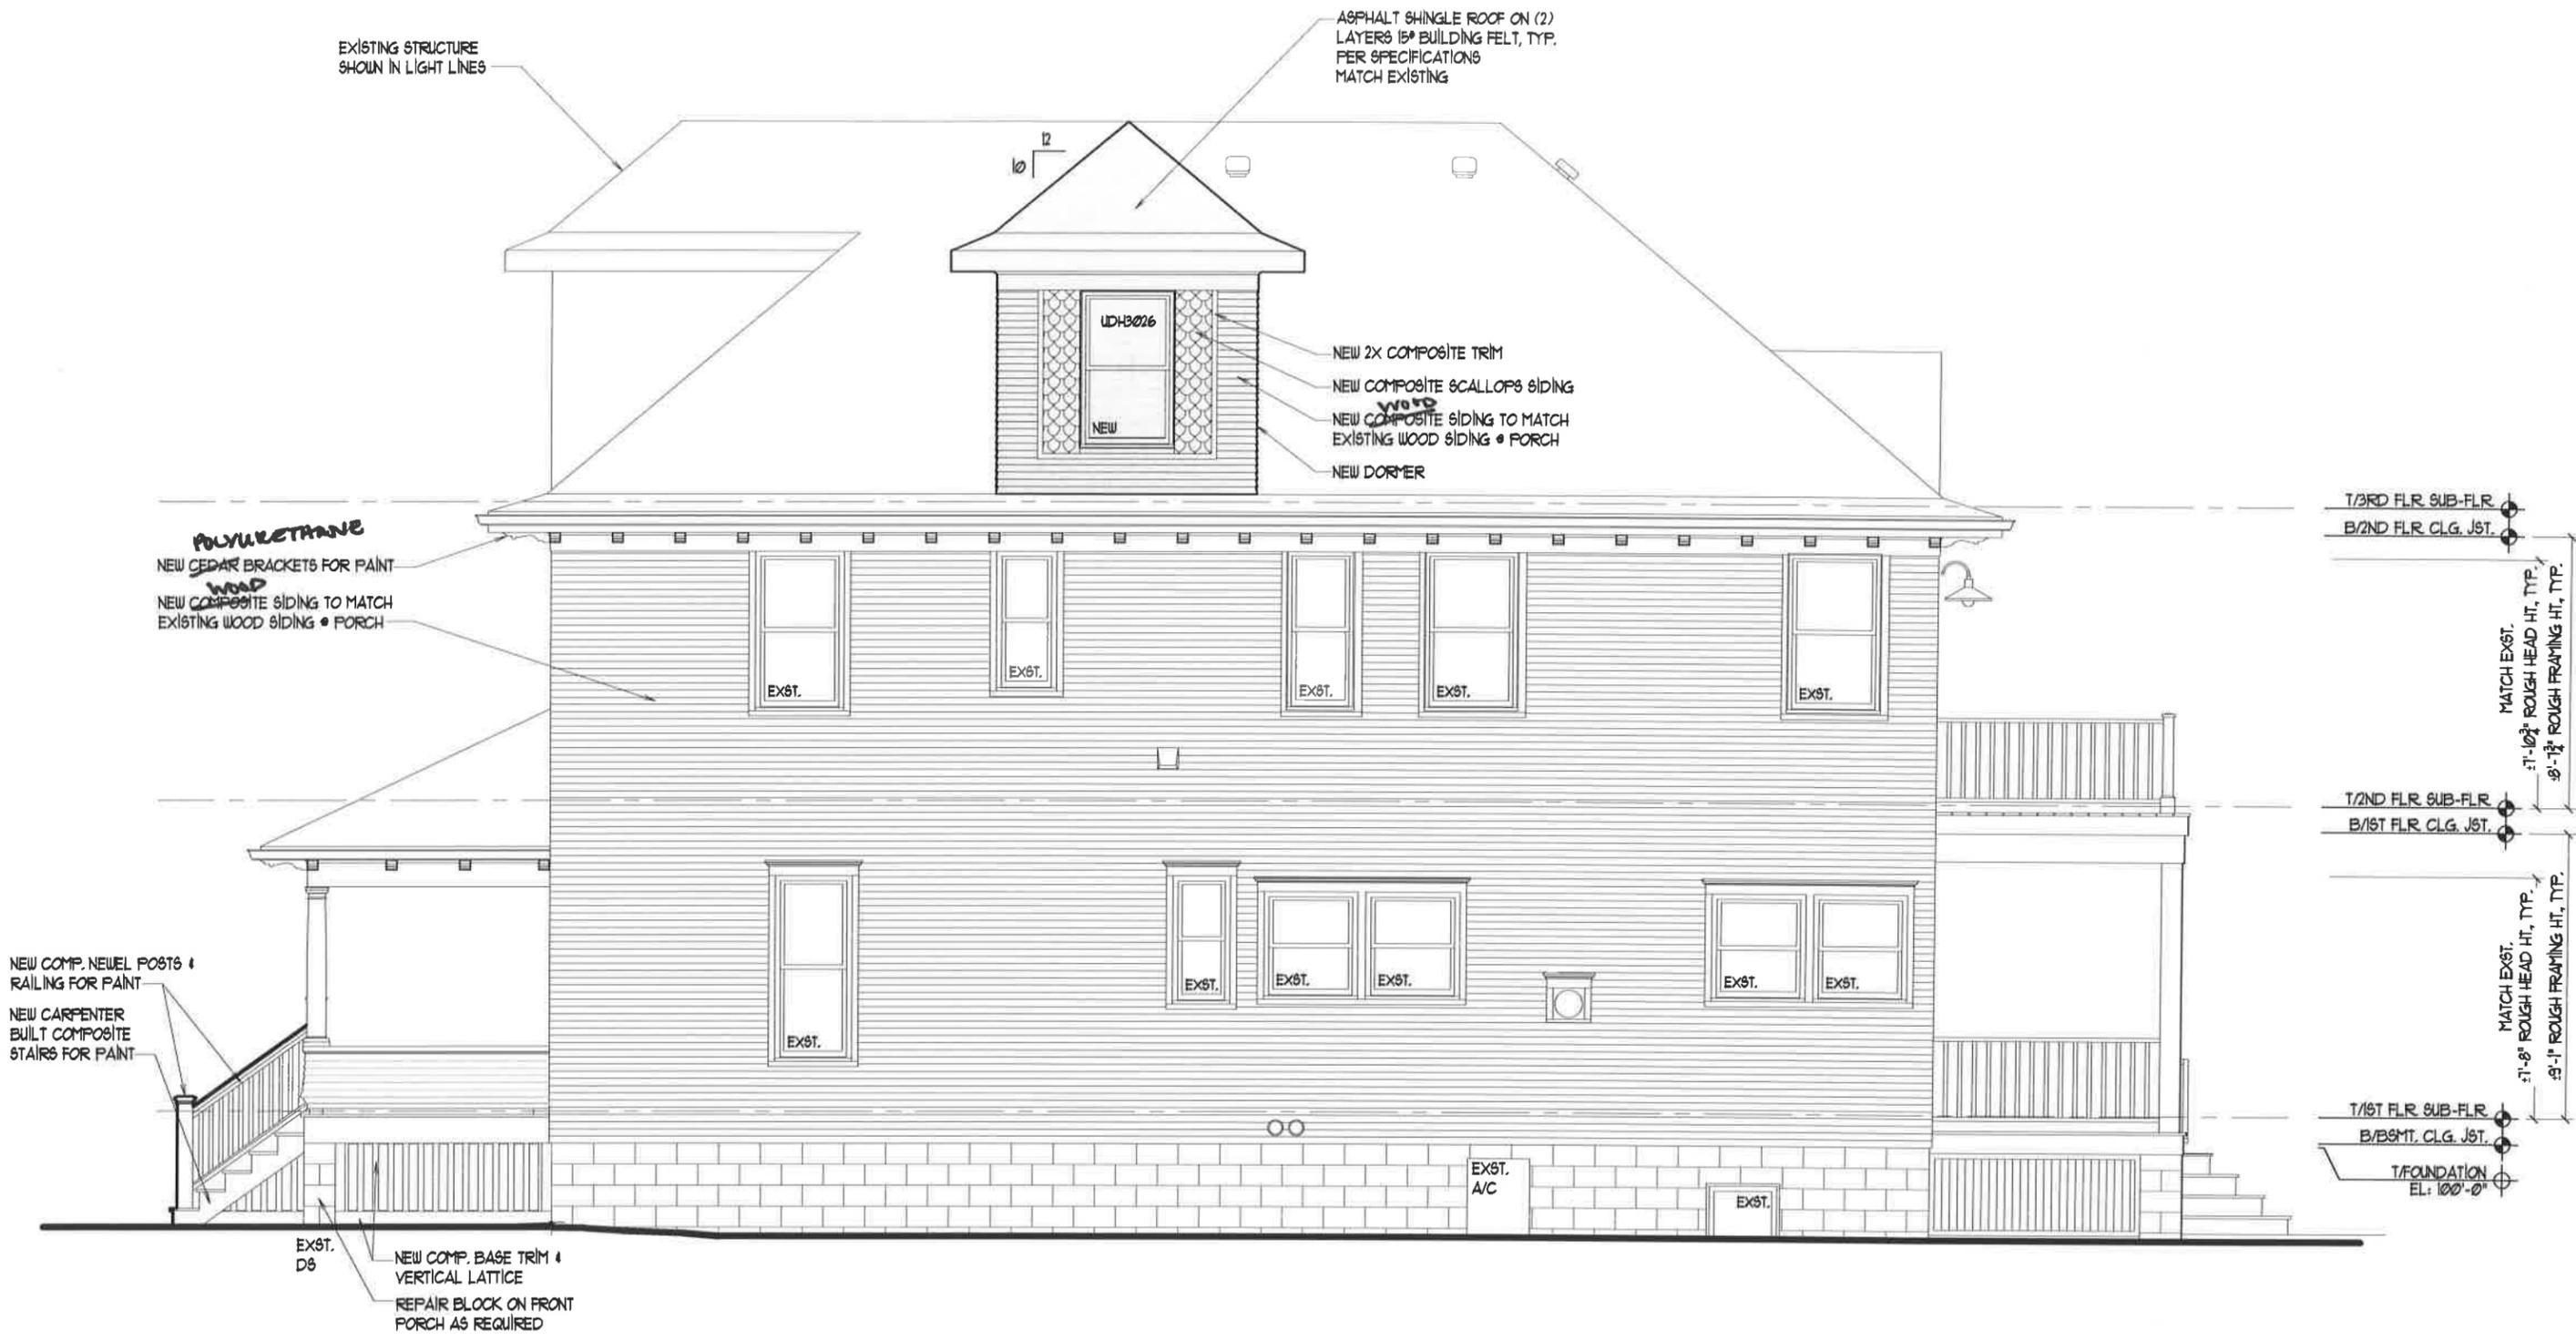

2

**SOUTH ELEVATION**

SCALE: 3/16" = 1'-0"

**NOTE:**  
NEW DORMERS SHADED FOR CLARITY



3



**EAST ELEVATION**

SCALE: 3/16" = 1'-0"

**NOTE:**  
NEW DORMERS SHADED FOR CLARITY





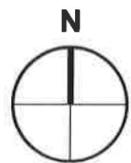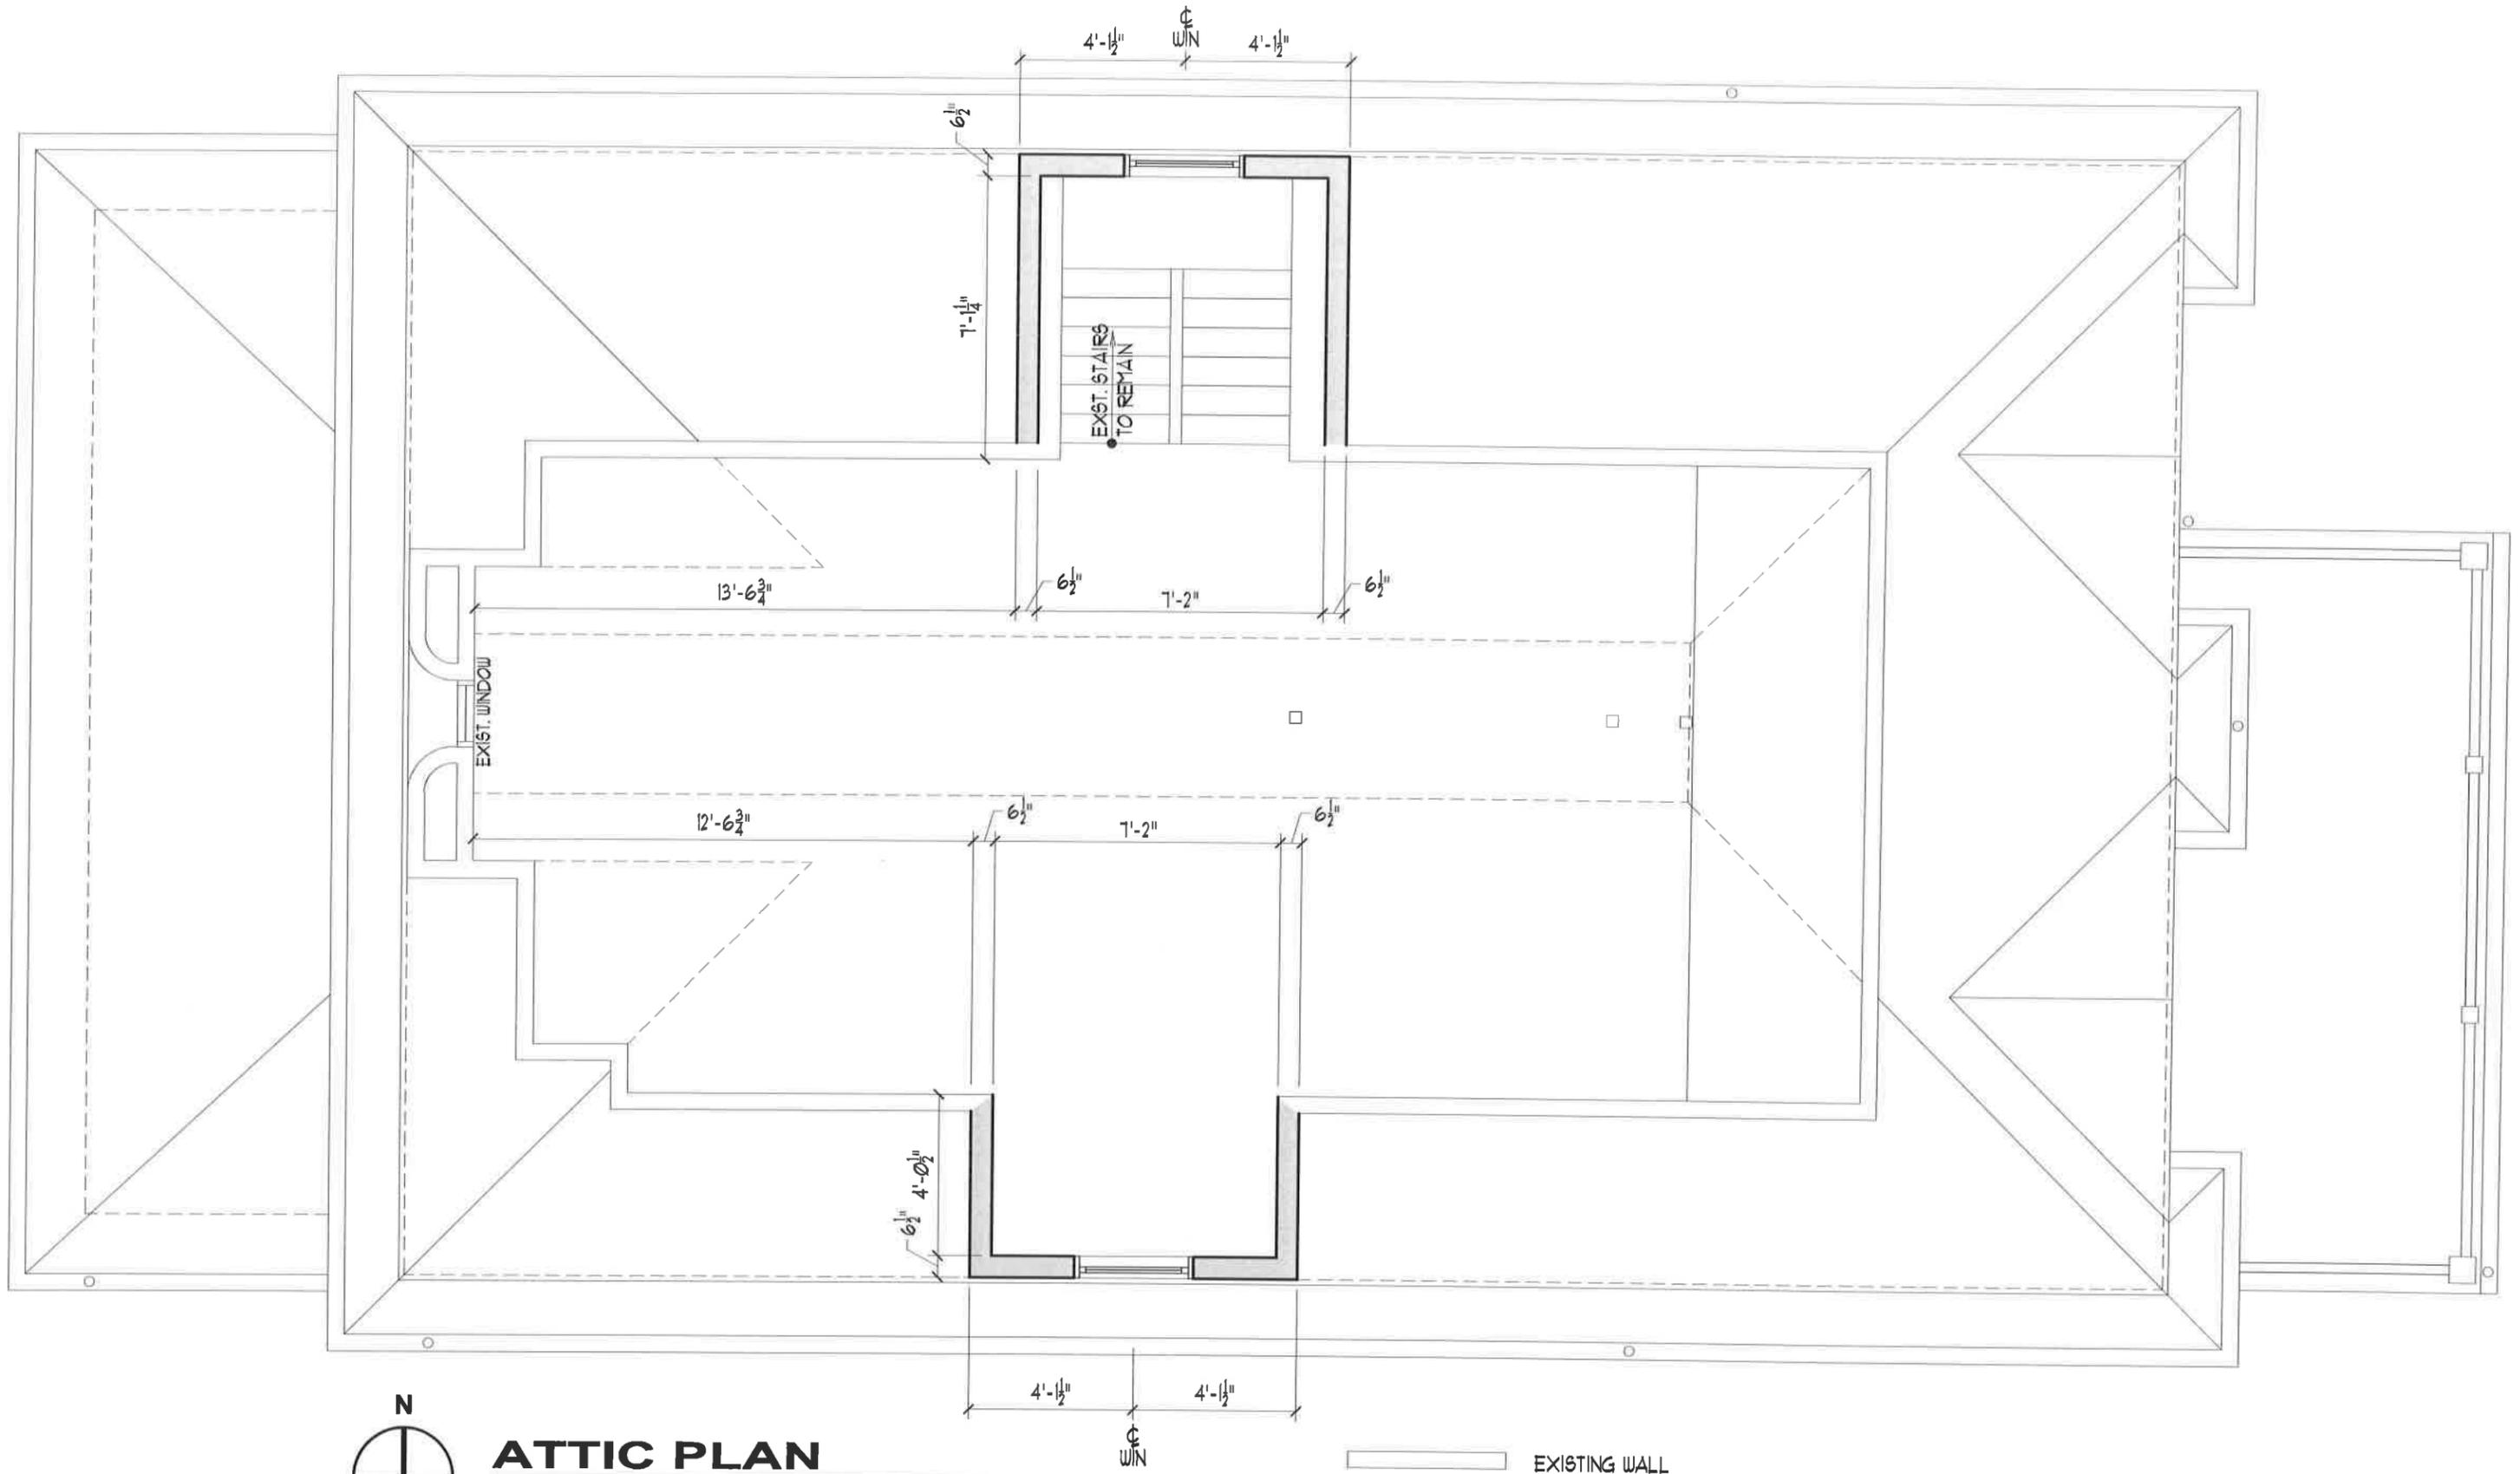

**ATTIC PLAN**

SCALE: 1/4" = 1'-0"

- EXISTING WALL
- NEW WALL