

This document, together with the concepts and designs presented herein, as an instrument of service, is intended only for the specific purpose and client for which it was prepared. Reuse of and improper reliance on this document without written authorization and adaptation by Kinley-Horn and Associates, Inc. shall be without liability to Kinley-Horn and Associates, Inc.



City of Naperville
**STANDARD
DETAIL**

790.10

1. A TREE PROTECTION AREA SHALL BE ESTABLISHED AROUND A TREE A DISTANCE OF ONE FOOT FOR EACH ONE INCH OF TREE DIAMETER, UP TO A MAXIMUM OF 30 FEET.
2. PROTECTIVE TREE FENCE SHALL BE INSTALLED AT THE LIMITS OF THE TREE PROTECTION AREA. THE FENCE SHALL BE HIGH ENOUGH SO AS TO BE VISIBLE TO ALL CONSTRUCTION PERSONNEL.
3. GRADE CHANGES, UTILITY TRENCHES, STORAGE OF CONSTRUCTION MATERIAL, DUMPING OF WASTE, OR OPERATION OR STORAGE OF ANY EQUIPMENT SHALL NOT BE ALLOWED WITHIN THE TREE PROTECTION AREA.
4. AUGURING IS REQUIRED IF A UTILITY MUST BE INSTALLED WITHIN THE TREE PROTECTION AREA. AUGURED UTILITIES MUST BE A MINIMUM OF 24 INCHES BELOW GRADE.
5. ALL TREES TO BE SAVED WHICH HAVE BEEN SUBJECTED TO CONSTRUCTION ACTIVITY WITHIN THE TREE PROTECTION AREA SHOULD BE SELECTIVELY THINNED 10% BY AN ARBORIST SKILLED AT THE SELECTIVE THINNING PROCEDURE. NONE OF THE TREES SHALL BE TOPPED, HEADED BACK, SKINNED (REMOVAL OF THE INTERIOR BRANCHES), OR CLIMBED WITH SPIKES. ALL DEAD WOOD SHOULD BE REMOVED TO AVOID HAZARD.
6. IT IS RECOMMENDED THAT FOLLOWING CONSTRUCTION, TREES BE MAINTAINED IN THEIR NATIVE CONDITION. NO LAWN SHOULD BE PLACED AROUND THE TREES. IT IS RECOMMENDED THAT THE AREA BE MULCHED WITH 2 INCHES OF DECOMPOSED LEAVES AND 2 INCHES OF WOOD CHIPS OR BARK.




THE CONTRACTOR SHALL HAVE THE TREE LIMBS PRUNED THAT MIGHT BE DAMAGED BY EQUIPMENT OPERATIONS PRIOR TO CONSTRUCTION COMMENCING.


— PROTECTIVE TREE
FENCE - TYP

ONE FOOT FOR
EACH ONE INCH
OF TREE DIA.
30' MAX

— EARTH SAWCUTTING OF THE TREE ROOTS TO BE PERFORMED AT THE LIMITS OF THE TREE PROTECTION AREA OR AS INDICATED ON THE PLANS (24" MINIMUM DEPTH).

CASEY'S NAPERVILLE #6531		TREE PRESERVATION PLAN				SCALE: AS NOTED DESIGNED BY: JTA DRAWN BY: TYC CHECKED BY: INS		Kimley»Horn © 2024 KIMLEY-HORN AND ASSOCIATES, INC. 570 LAKE COOK ROAD, SUITE 200 NAPERVILLE, IL 60563 PHONE: 647-260-7804 WWW.KIMLEY-HORN.COM		REVISED PER SITE CHANGES REVISED PER CITY REVISED PER CITY REVISED PER 100T & CITY REVISED PER CITY REVISIONS		JTA JTA JTA INS INS BY		07/07/25 05/14/25 04/10/25 03/07/25 11/26/24 DATE	
ORIGINAL ISSUE: 10/01/2024		KHA PROJECT NO. 168865042		SHEET NUMBER		C-100A									

Drawing name: K:\GIS_LDEV\168865042_casey's_6531_naperville_110 LANDSCAPE PLAN.dwg C-701 LANDSCAPE PLAN.dwg Jul 03, 2025 3:37pm By: Christina Marelli
This document, together with the concepts and designs presented herein, is intended only for the specific purpose and client for which it was prepared. Reuse of and improper reliance on this document without written authorization and adaptation by Kimley-Horn and Associates, Inc. shall be without liability to Kimley-Horn and Associates, Inc.

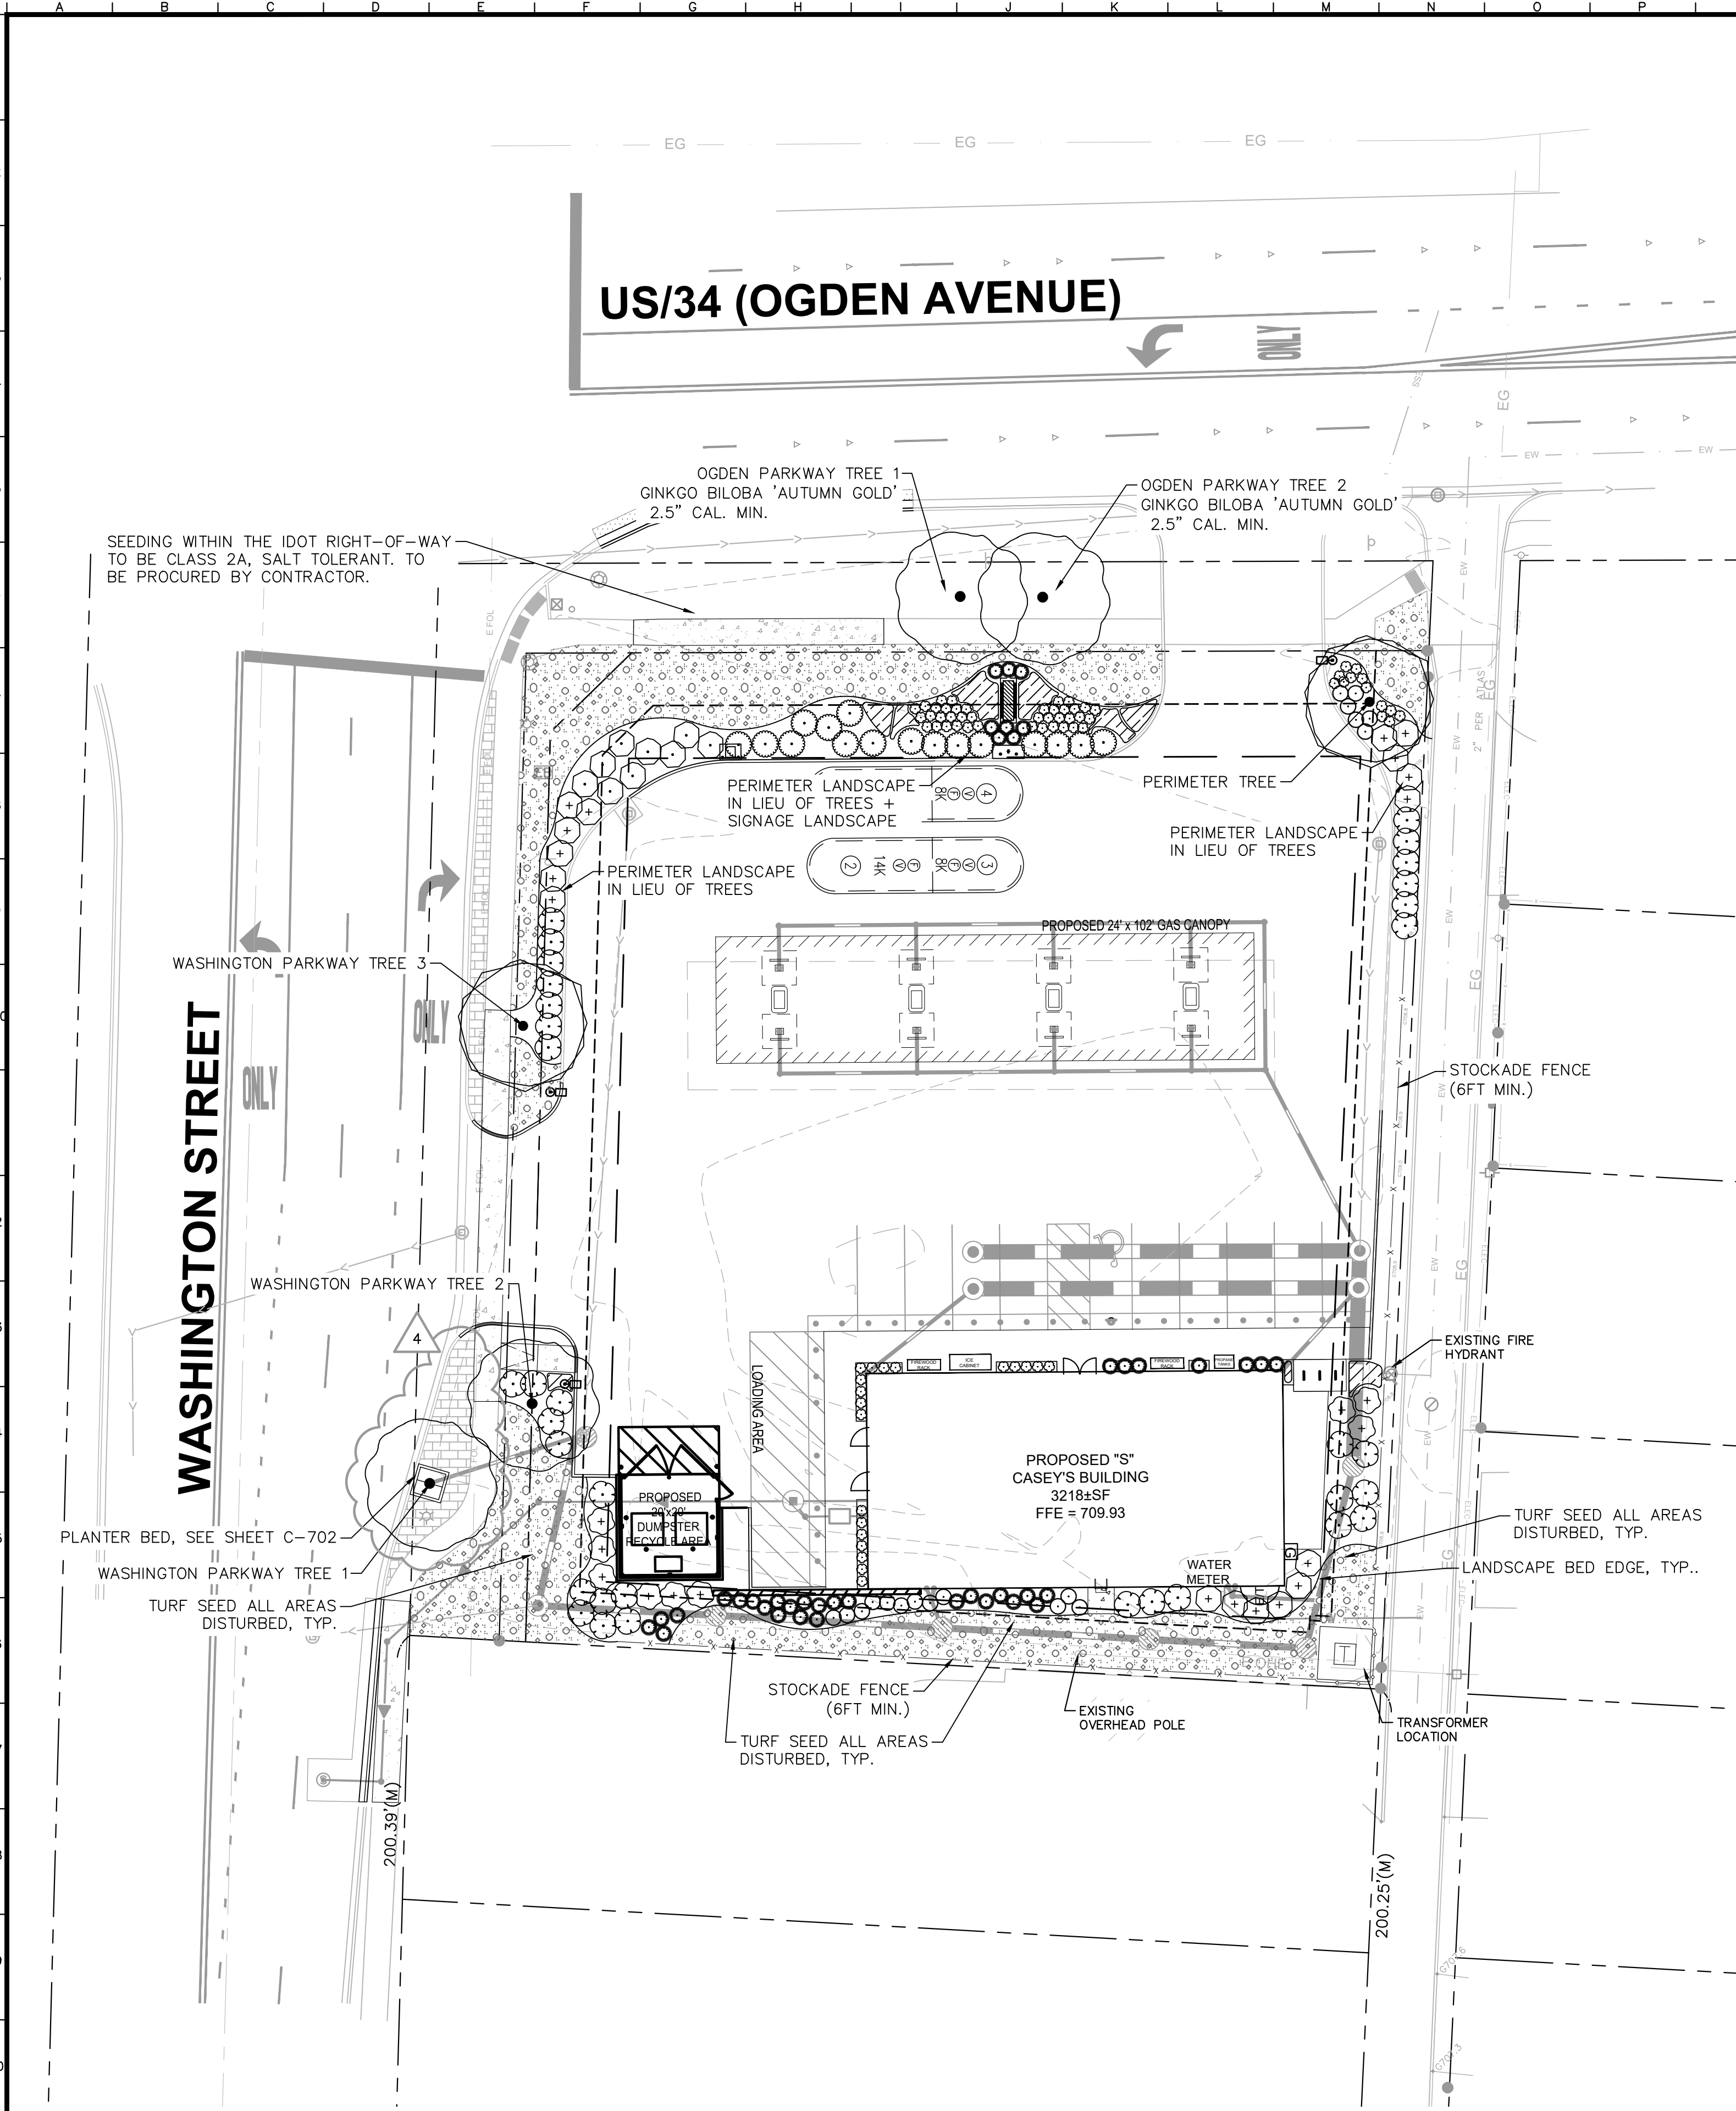

NOTE: ALL LANDSCAPE BEDS TO BE MULCHED WITH 1/2" DIAMETER DECORATIVE CA-11 ROUNDED RIVER ROCK. SEE STONE MULCH DETAILS ON SHEET C-702.

EXHIBIT E

NAPERVILLE, IL LANDSCAPE CODE REQUIREMENTS		
ZONING ORDINANCE	REQUIRED	PROPOSED
SECTION 5-10-3-3 - PARKWAY LANDSCAPING		
PARKWAY TREES SHALL BE EVENLY SPACED AT NOT MORE THAN 40 FEET APART AND NOT LESS THAN FOUR FEET FROM THE ESTABLISHED SIDEWALK LINE OF SAID STREET, EXCLUSIVE OF WIDTHS OF CURB CUTS, AND THE 30-FOOT LINE OF SITE TRIANGLE AT THE INTERSECTION OF TWO STREETS	3 PARKWAY TREES REQUIRED ALONG WASHINGTON STREET	3 TREES PROVIDED ALONG WASHINGTON STREET
	2 PARKWAY TREES REQUIRED ALONG OGDEN AVENUE	2 TREES PROVIDED ALONG OGDEN AVE
SECTION 5-10-3-4.1-2 PERIMETER TREE REQUIREMENTS		
SHADE TREES AND/OR EVERGREEN TREES SHALL BE SPACED AT THE EQUIVALENT OF NOT MORE THAN 70 FEET APART ALONG ALL PROPERTY LINES, EXCLUSIVE TO ACCESS DRIVES PERPENDICULAR TO LOT LINES.	164 LINEAR FT. / 70 FT = 3 TREES REQUIRED ALONG THE WEST (WASHINGTON STREET) 127 LINEAR FT. / 70 FT = 2 TREES REQUIRED ALONG THE NORTH (OGDEN AVENUE) 184 LINEAR FT. / 70 FT = 3 TREES REQUIRED ALONG THE SOUTH 196 LINEAR FT. / 70 FT = 3 TREES REQUIRED ALONG THE EAST (WASHINGTON ALLEY)	1 TREE PROVIDED ALONG OGDEN AVENUE AND SHRUBS PROVIDED ELSEWHERE IN LIEU OF TREES
SECTION 5-10-3-4.3 NON RESIDENTIAL ADJACENT TO RESIDENTIAL ZONES		
WHEN A NONRESIDENTIAL PROPERTY IS ADJACENT TO A SIDE YARD OF A RESIDENTIAL PROPERTY, A CONTINUOUS LANDSCAPE BUFFER WILL BE PROVIDED AS FOLLOWS IN ACCORDANCE WITH EXHIBIT L. THE BUFFER SHALL BE MAINTAINED TO A MINIMUM HEIGHT OF 3 FEET WHEN ADJACENT TO THE SIDE YARD OF THE NONRESIDENTIAL PROPERTY.	A CONTINUOUS LANDSCAPE BUFFER MAINTAINED AT A MINIMUM HEIGHT OF 3 FEET REQUIRED ALONG THE SOUTH SIDE OF PROPERTY	6FT MIN STOCKADE FENCE PROVIDED ALONG SOUTH SIDE PROPERTY LINE
SECTION 5-10-3-5.2.3.1 PERIMETER PARKING LOT LANDSCAPING - ACROSS FROM RESIDENTIAL		
CONTINUOUS LANDSCAPING SHALL BE PROVIDED ACROSS 100% OF THE PARKING LOT, EXCLUSIVE OF DRIVEWAYS TO A MINIMUM HEIGHT OF 30 INCHES. SUCH LANDSCAPING SHALL CONSIST OF EVERGREEN AND DECIDUOUS SHRUBBERY AND/OR HEDGES.	CONTINUOUS LANDSCAPING ACROSS 100% OF THE PARKING LOT REQUIRED ALONG THE EAST (WASHINGTON ALLEY)	6FT MIN STOCKADE FENCE PROVIDED ALONG PROPERTY LINE IN ADDITION TO 30" HT MIN SHRUBS, 4 FT O.C. SPACING
SECTION 5-10-3-5.2.3.2 PERIMETER PARKING LOT LANDSCAPING - ACROSS FROM NON-RESIDENTIAL		
CONTINUOUS LANDSCAPING SHALL BE PROVIDED ACROSS 50% OF THE PARKING LOT, EXCLUSIVE OF DRIVEWAYS TO A MINIMUM HEIGHT OF 30 INCHES. SUCH LANDSCAPING SHALL CONSIST OF EVERGREEN AND DECIDUOUS SHRUBBERY AND/OR HEDGES.	CONTINUOUS LANDSCAPING ACROSS 50% OF THE PARKING LOT REQUIRED ALONG WASHINGTON STREET AND OGDEN AVENUE	30" HT MIN SHRUBS, 4 FT O.C SPACING PROVIDED ALONG WASHINGTON STREET AND OGDEN AVENUE PROPERTY LINES
SECTION 5-10-4-2.1 - FOUNDATION LANDSCAPING		
FOUNDATION PLANTINGS SHALL BE LOCATED ADJACENT TO ALL SIDES OF BUILDINGS WHICH FACE A PUBLIC RIGHT-OF-WAY OR INTERNAL STREET ACCESS DRIVE, OTHER THAN SINGLE-FAMILY ATTACHED AND DETACHED DEVELOPMENTS AND PROPERTIES ZONED B4 OR B5, IN A PLANTING BED A MINIMUM OF 2 FEET IN WIDTH. FOUNDATION PLANTINGS SHALL CONSIST OF A MINIMUM RATIO OF ONE PLANT FOR EVERY 3 LINEAR FEET OF BUILDING LENGTH. ALL PLANTING AREAS WHICH ARE NOT OCCUPIED BY TREES, SHRUBS, FLOWERS, GROUND COVER, ORNAMENTAL GRASSES OR MULCH SHALL BE SODDED OR CONTAIN DECORATIVE LANDSCAPE STONE APPROVED BY THE ZONING ADMINISTRATOR.	119.8 LF FOUNDATION 119.8 LF / 3 LF = 40 40 X (1) PLANT = 40 PLANTS 40 PLANTS REQUIRED ALONG FOUNDATION	27 PLANTS PROVIDED ALONG FOUNDATION ON THE NORTH AND WEST (ALL NOT PROVIDED DUE TO SPACE CONSTRAINTS) 45 PLANTS PROVIDED ALONG FOUNDATION ON THE SOUTH AND EAST
SECTION 6-16-7-3 - GROUND SIGN LANDSCAPE REQUIREMENT		
THE LANDSCAPE REQUIREMENT IS DETERMINED BY CALCULATING THE AREA OF THE LANDSCAPED AREA AROUND THE BASE OF THE GROUND SIGN. THE SIGN AREA IS DETERMINED BY CALCULATION THE MEASUREMENT OF THE OUTER DIMENSIONS OF SIGN.	DIMENSIONS OF DOUBLE-SIDED SIGN: 5' 7" X 7' = 39 SQ.FT. 39 SQ.FT X 2 = 78 SQ.FT. OF REQUIRED LANDSCAPE AREA	78 SQ.FT. OF LANDSCAPE AREA PROVIDED

PLANT SCHEDULE

SYMBOL	CODE	QTY	REMARKS	BOTANICAL / COMMON NAME	CONT	CAL	SIZE
TREES							
	GA	4	50'-80' HT.	GINKGO BILOBA 'AUTUMN GOLD' / AUTUMN GOLD MAIDENHAIR TREE	B & B	2.5" CAL. MIN.	
	QB	2	50'-60' HT.	QUERCUS BICOLOR / SWAMP WHITE OAK	B & B	2.5" CAL. MIN.	
SHRUBS							
	DD	73	1'-2' HT.	DEUTZIA X 'NCDX2' / YUKI CHERRY BLOSSOM® DEUTZIA	3 GAL.	SEE PLAN	12" HT. MIN.
	VR	9	3'-4' HT.	DIERVILLA RIVULARIS 'SMNDRSF' / KODIAK® BLACK HONEYSUCKLE	5 GAL.	SEE PLAN	30" HT. MIN.
	HJ	16	3'-5' HT.	HYDRANGEA PANICULATA 'JANE' / LITTLE LIME® PANICLE HYDRANGEA	5 GAL.	SEE PLAN	30" HT. MIN.
	JF	9	10'-15' HT.	JUNIPERUS CHINENSIS 'FAIRVIEW' / FAIRVIEW JUNIPER	B & B	SEE PLAN	6' HT. MIN.
	JF2	17	4'-6' HT.	JUNIPERUS CHINENSIS 'SEA GREEN' / SEA GREEN JUNIPER	5 GAL.	SEE PLAN	30" HT. MIN.
	PW	18	2'-3' HT.	POTENTILLA FRUTICOSA 'WHITE LADY' / HAPPY FACE® WHITE BUSH CINQUEFOIL	3 GAL.	SEE PLAN	18" HT. MIN.
	VM	34	3'-5' HT.	VIBURNUM DENTATUM 'BLUE MUFFIN' / BLUE MUFFIN ARROWWOOD VIBURNUM	5 GAL.	SEE PLAN	36" HT. MIN.
ORNAMENTAL GRASSES							
	CK	40	3'-5' HT.	CALAMAGROSTIS X ACUTIFLORA 'KARL FOERSTER' / KARL FOERSTER FEATHER REED GRASS	1 GAL.		
PERENNIALS							
	HC	107	24"-36" HT.	HEMEROCALLIS X 'CHERRY CHEEKS' / CHERRY CHEEKS DAYLILY	1 GAL.	SEE PLAN	
GROUND COVERS							
				TURF SEED			

GRAPHIC SCALE IN FEET
0 10 20 40

Call Before You Dig
JULIE
1-800-892-0123

NORTH

REVISIONS

DATE	BY	REVISIONS
07/07/25	JTA	REVISED PER SITE CHANGES
05/14/25	JTA	REVISED PER CITY
04/10/25	JTA	REVISED PER IDOT & CITY
03/07/25	INS	REVISED PER CITY
11/26/24	INS	REVISED PER CITY

SCALE:

AS NOTED	DESIGNED BY: JTA	DRAWN BY: TVC	CHECKED BY: INS
----------	------------------	---------------	-----------------

Kimley»Horn

© 2024 KIMLEY-HORN AND ASSOCIATES, INC.
570 LAKE COOK ROAD, SUITE 200
NAPERVILLE, IL 60563
PHONE: 630-267-7804
WWW.KIMLEY-HORN.COM

LANDSCAPE PLAN

CASEY'S
NAPERVILLE #6531

20 E. OGDEN AVE
NAPERVILLE, IL 60563

ORIGINAL ISSUE:
10/01/2024


KHA PROJECT NO.
168865042

SHEET NUMBER




C-701

Drawing name: K:\CHS_LDE\168865042_casey's_6531_naperville\1.0 LANDSCAPE PLAN.dwg
C-702 LANDSCAPE NOTES & DETAILS
This document, together with the concepts and designs presented herein, is intended only for the specific purpose and client for which it was prepared. Reuse of and improper reliance on this document without written authorization and adaptation by Kimley-Horn and Associates, Inc. shall be without liability to Kimley-Horn and Associates, Inc.


by: Christina Merelli
Jul 03, 2025 3:37pm

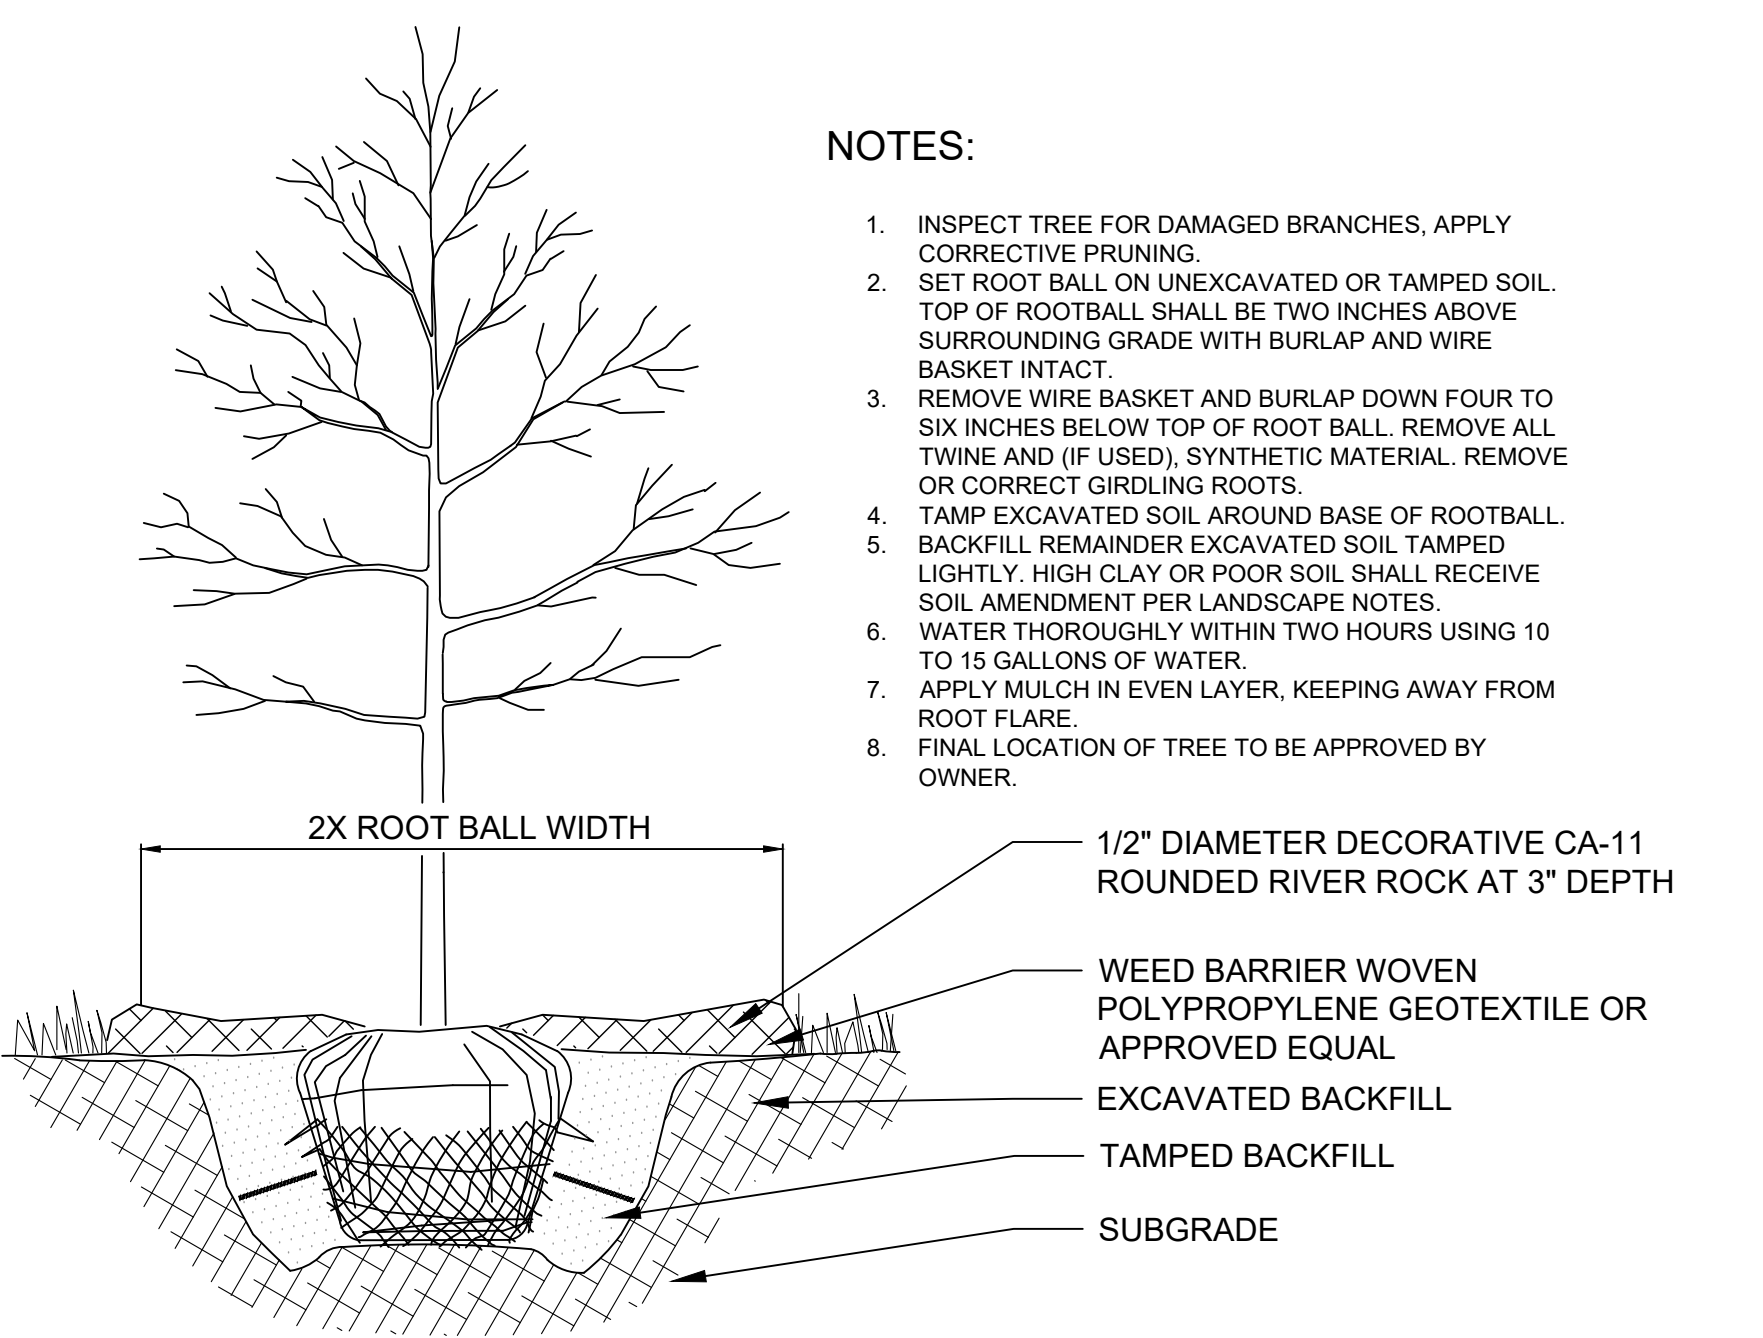

1 TREE PLANTING

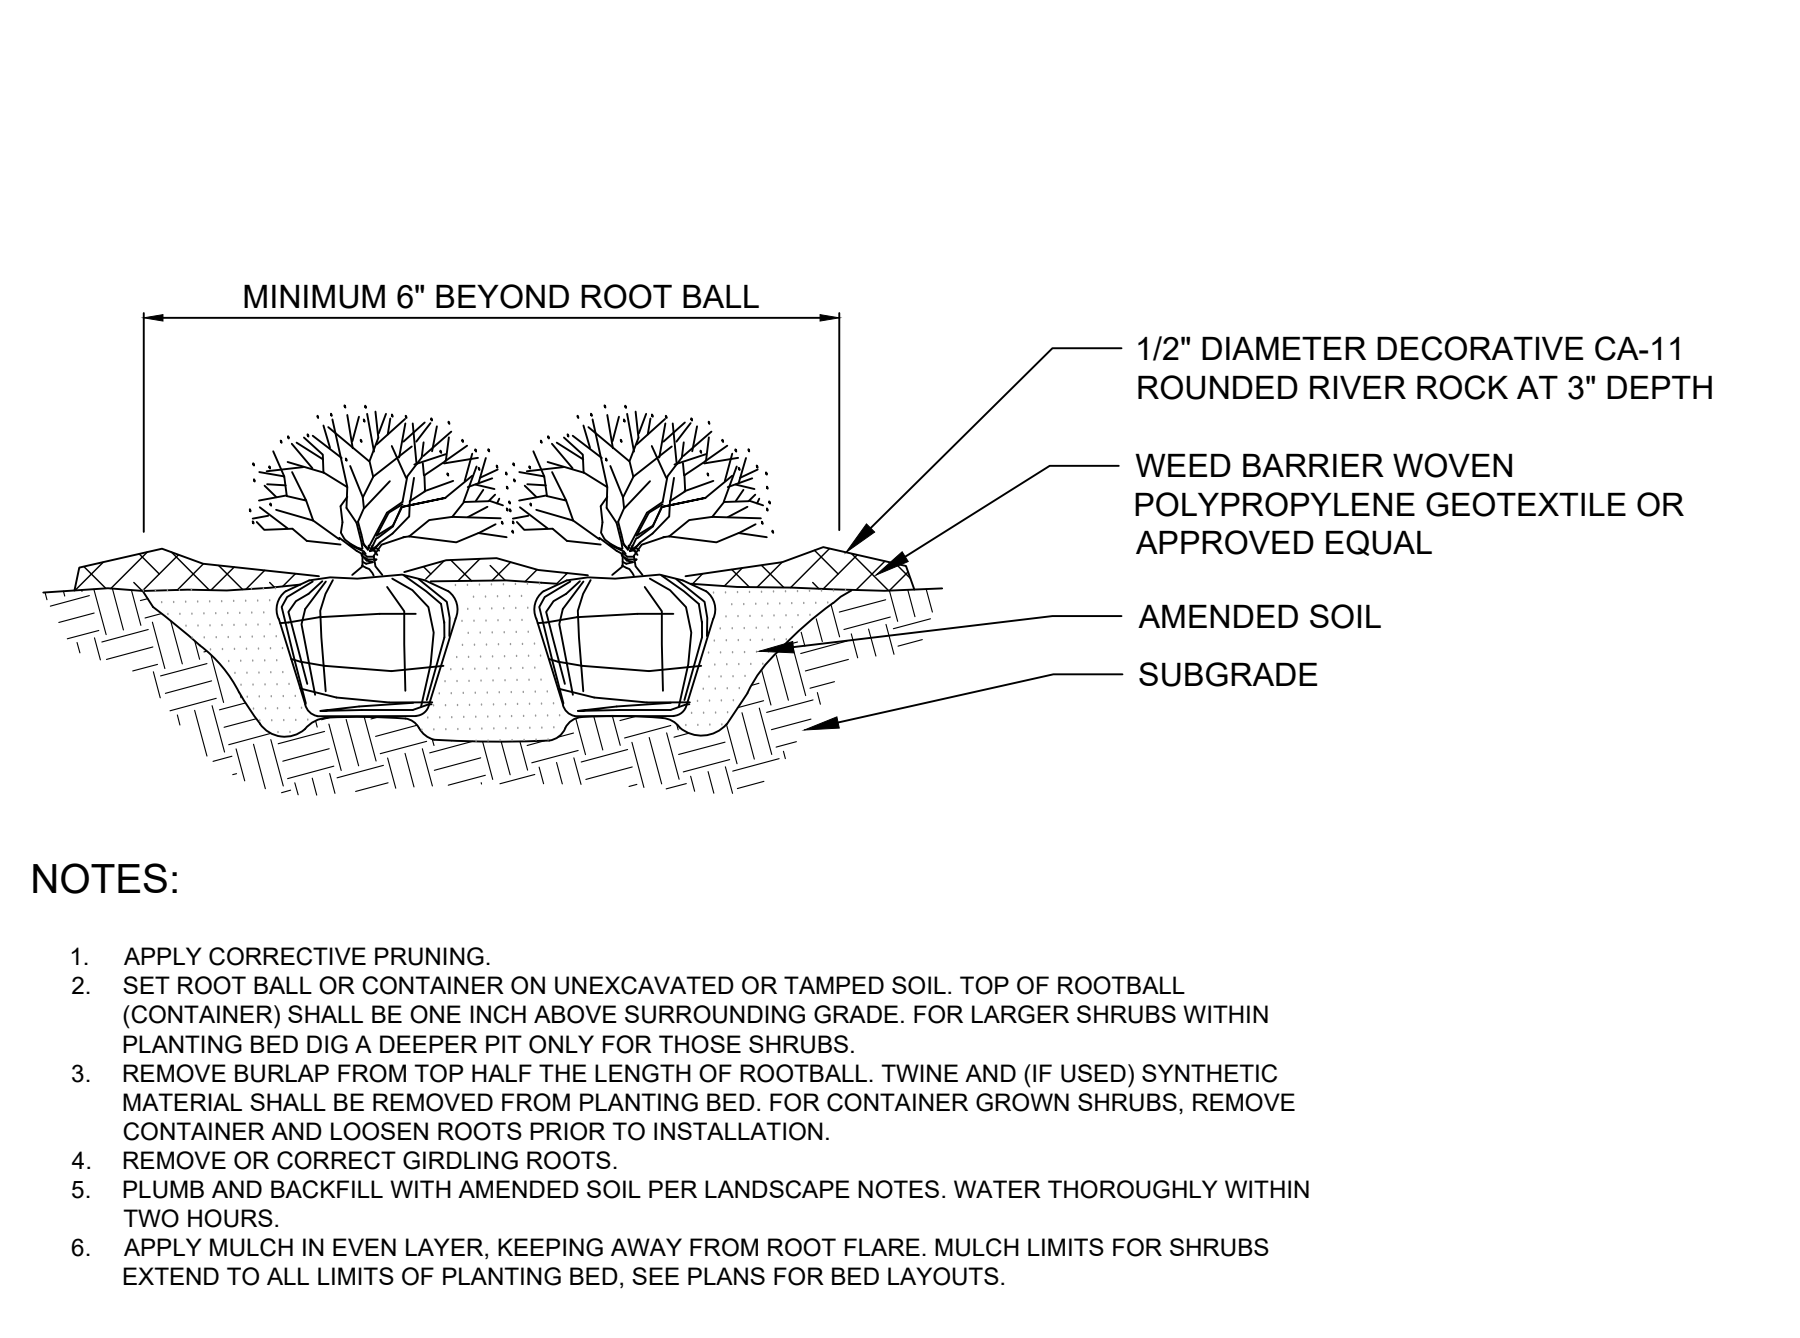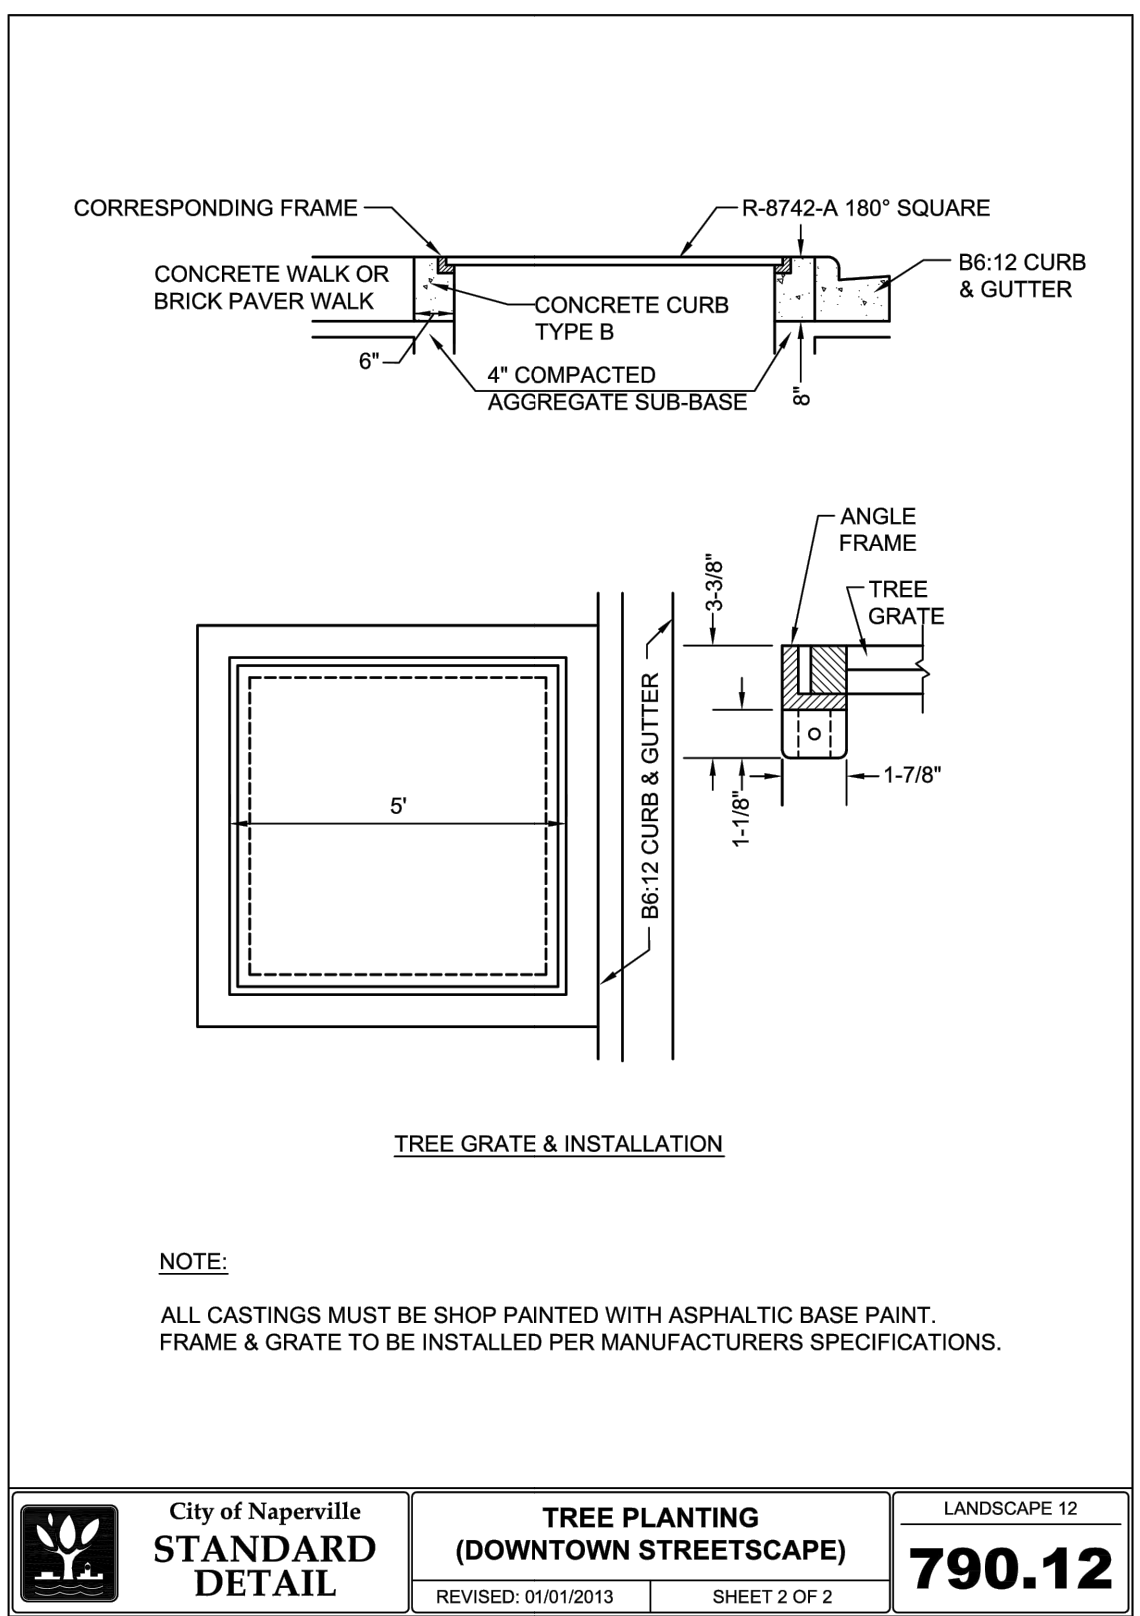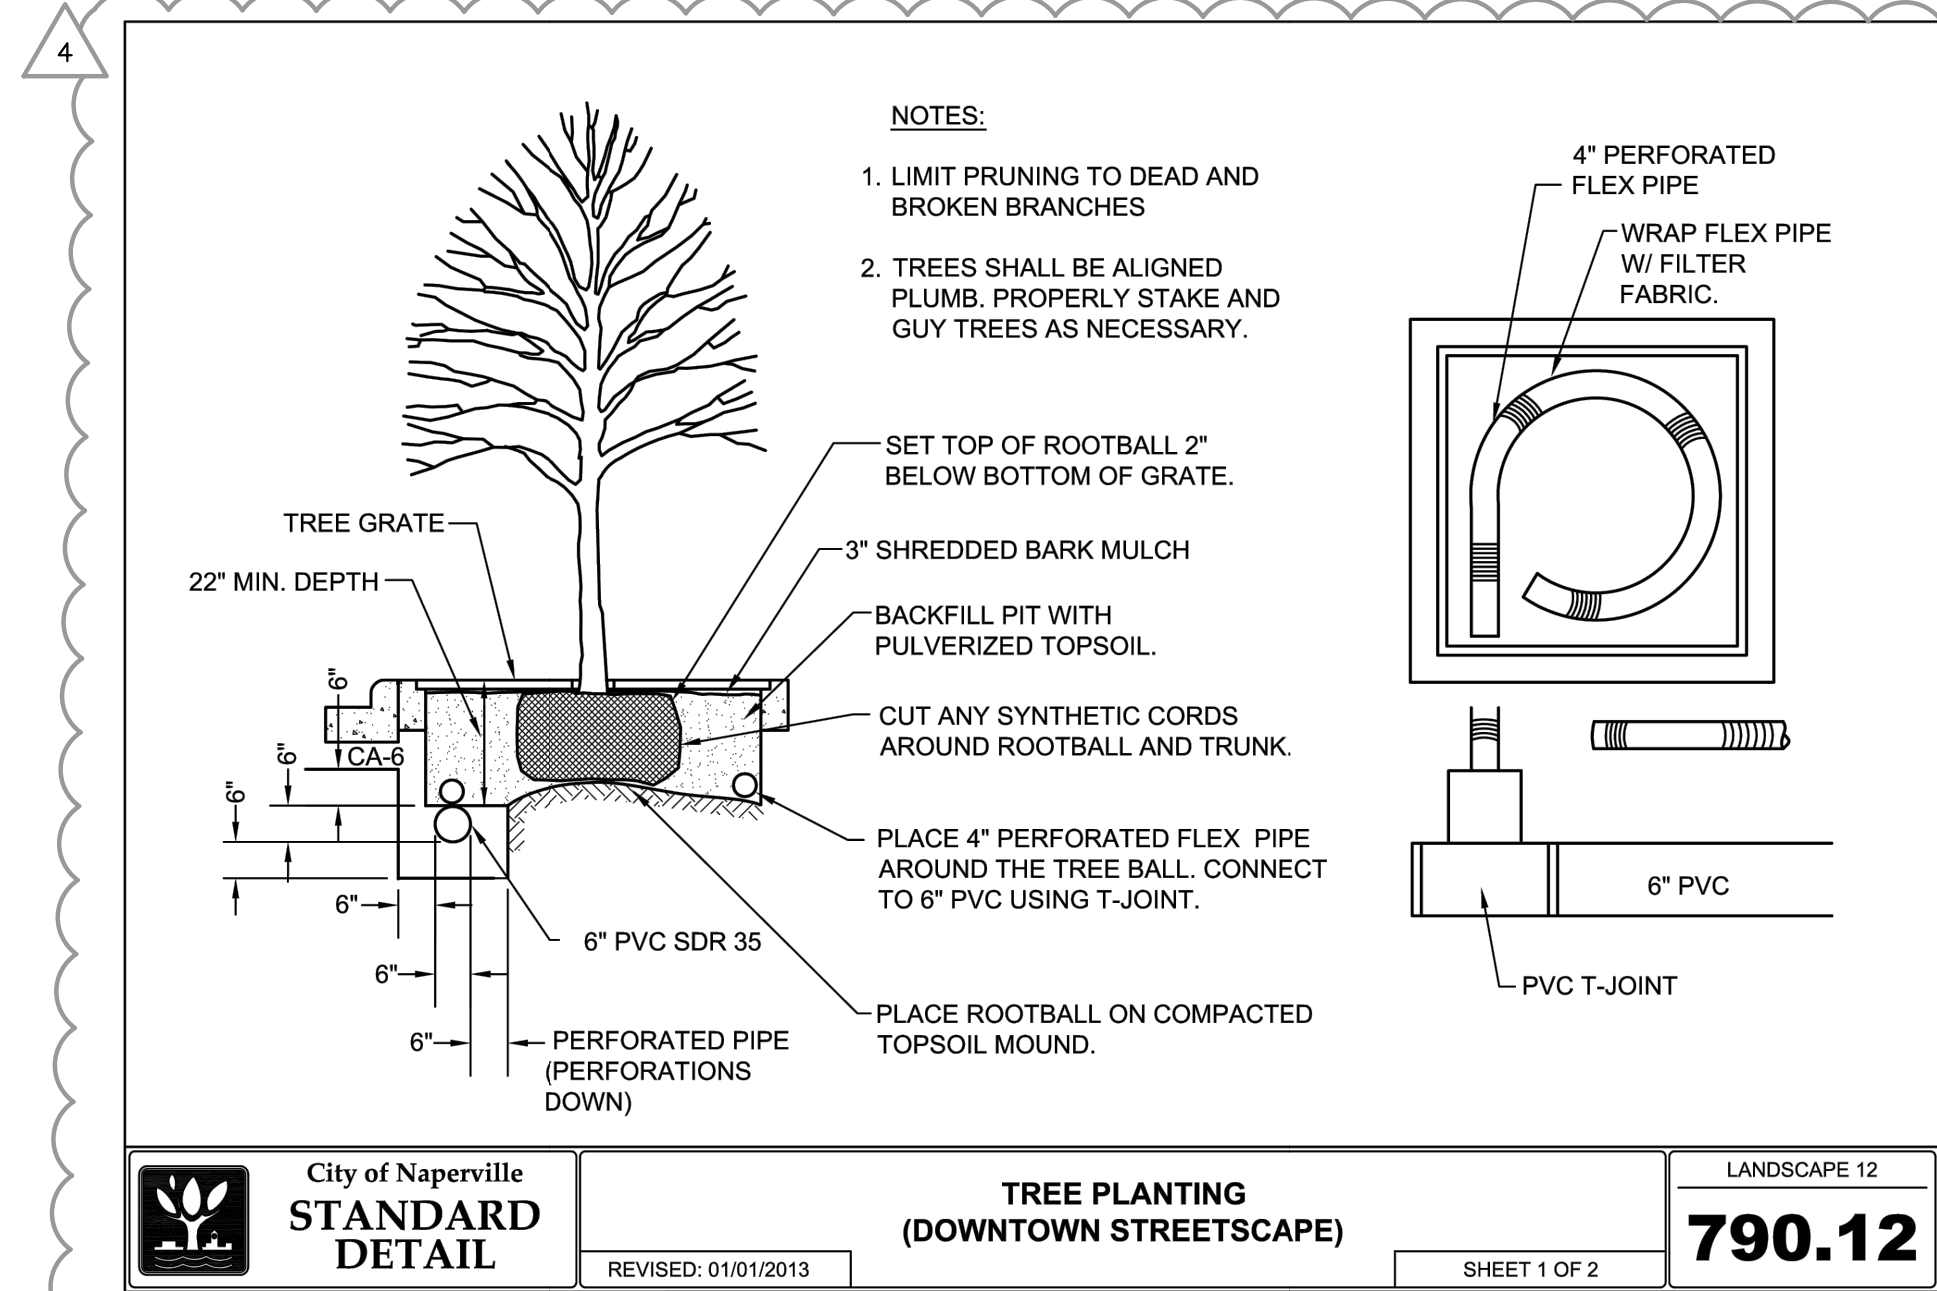

2 SHRUB PLANTING

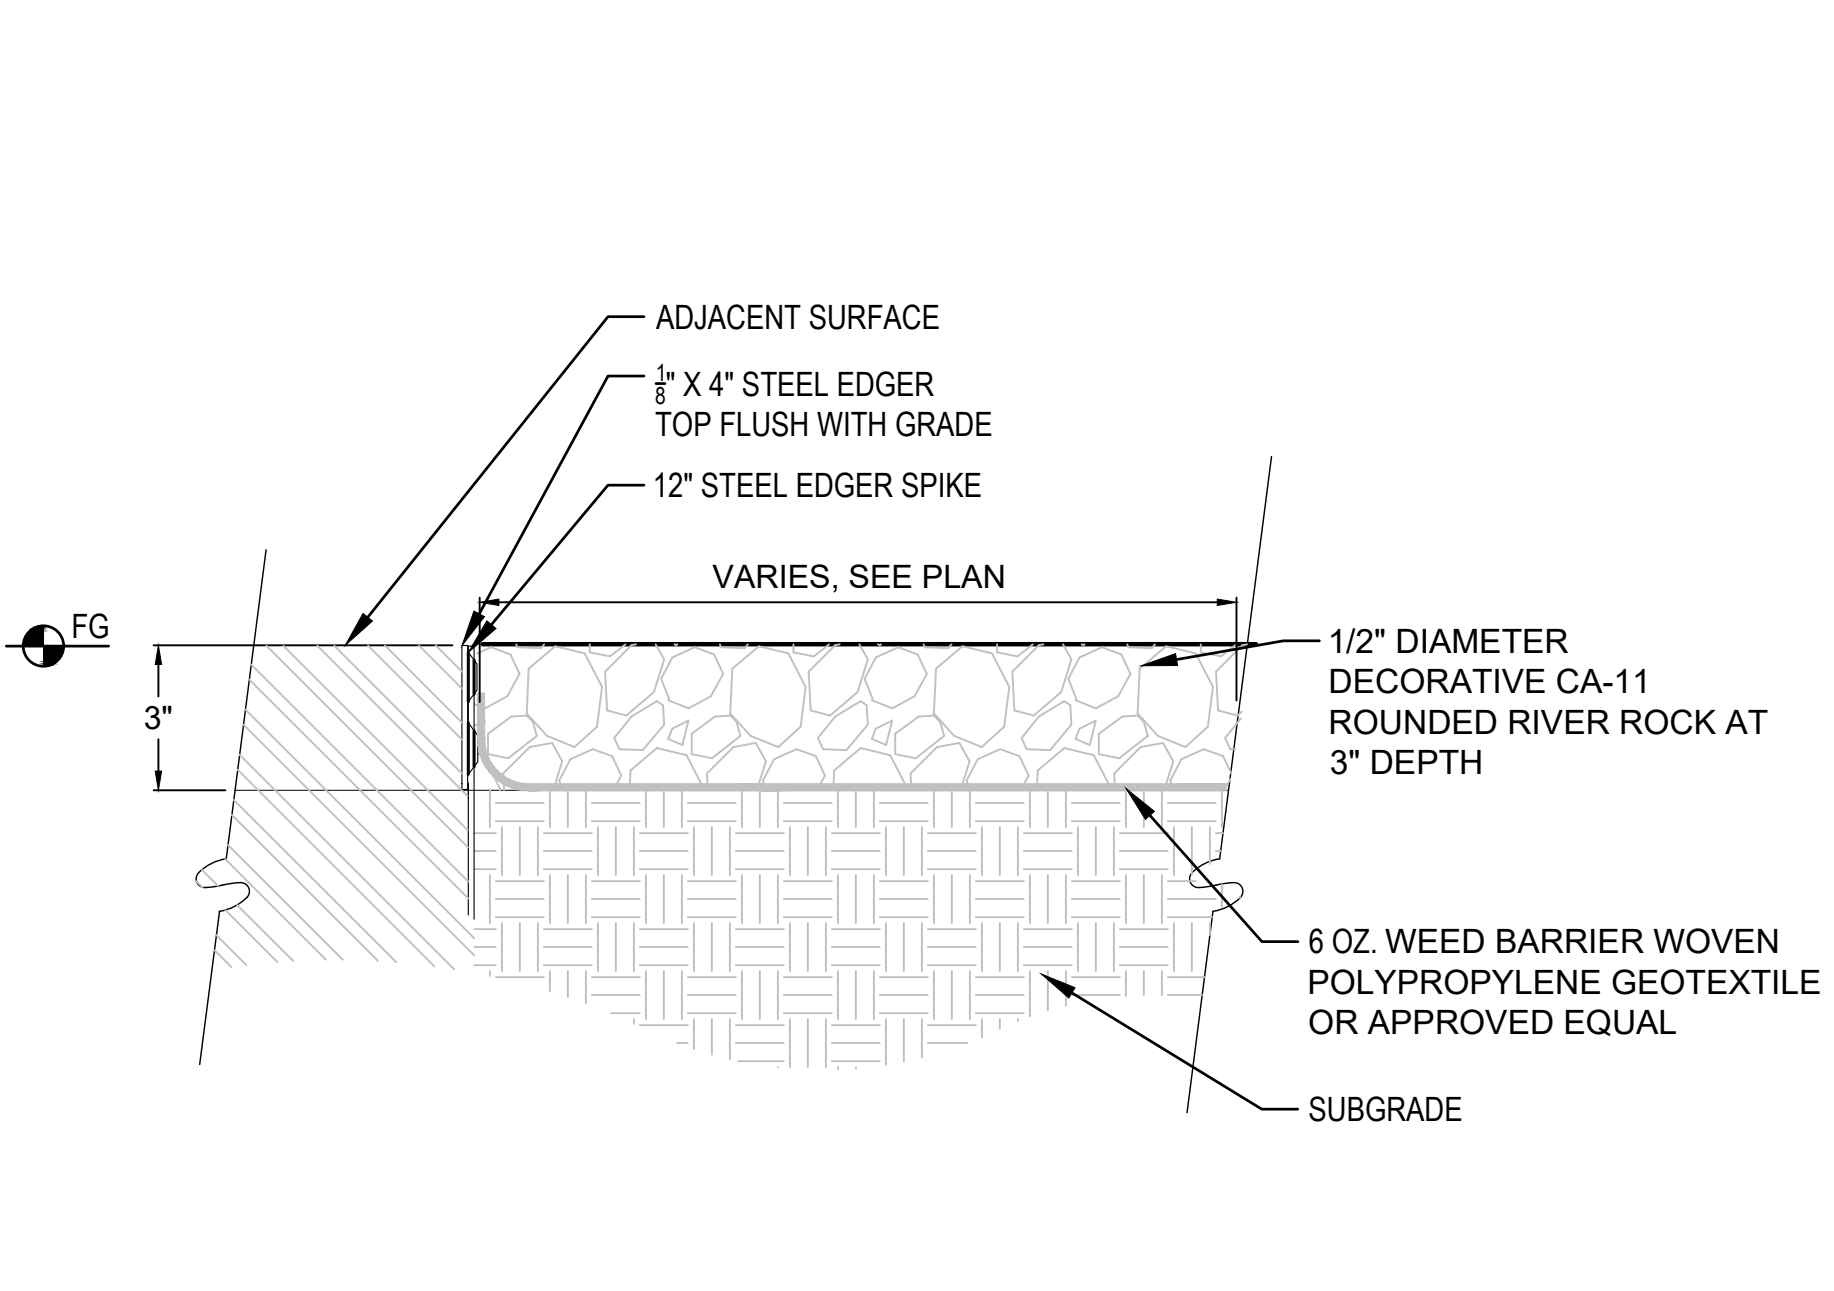


4 STONE MULCH

LANDSCAPE NOTES


1. THE LANDSCAPE CONTRACTOR SHALL BE RESPONSIBLE FOR INSTALLING MATERIALS AND PLANTS SHOWN ON THE LANDSCAPE PLAN. THE CONTRACTOR IS RESPONSIBLE FOR THE COST TO REPAIR UTILITIES, ADJACENT LANDSCAPE, PUBLIC AND PRIVATE PROPERTY THAT IS DAMAGED BY THE CONTRACTOR OR THEIR SUBCONTRACTOR'S OPERATIONS DURING INSTALLATION OR DURING THE SPECIFIED MAINTENANCE PERIOD. CALL FOR UTILITY LOCATIONS PRIOR TO ANY EXCAVATION.
2. THE CONTRACTOR SHALL REPORT ANY DISCREPANCY IN PLAN VS. FIELD CONDITIONS IMMEDIATELY TO THE LANDSCAPE ARCHITECT, PRIOR TO CONTINUING WITH THAT PORTION OF WORK.
3. NO PLANTING WILL BE INSTALLED UNTIL ALL GRADING AND CONSTRUCTION HAS BEEN COMPLETED IN THE IMMEDIATE AREA.
4. THE CONTRACTOR SHALL BE RESPONSIBLE FOR THE REPAIR OF ANY OF THEIR TRENCHES OR EXCAVATIONS THAT SETTLE.
5. ALL PLANTS TO BE SPECIMEN GRADE, WELL BRANCHED, HEALTHY, FULL, PRE-INOCULATED AND FERTILIZED. PLANTS SHALL BE FREE FROM DISEASE, PESTS, WOUNDS, AND SCARS. PLANTS SHALL BE FREE FROM NOTICEABLE GAPS, HOLES, OR DEFORMITIES. PLANTS SHALL BE FREE FROM BROKEN OR DEAD BRANCHES. TRUNKS WILL BE WRAPPED IF NECESSARY TO PREVENT SUN SCALD AND INSECT DAMAGE. THE LANDSCAPE CONTRACTOR SHALL REMOVE THE WRAP AT THE PROPER TIME AS PART OF THIS CONTRACT.
6. THE OWNER'S REPRESENTATIVE MAY REJECT ANY PLANT MATERIALS THAT ARE DISEASED, DEFORMED, OR OTHERWISE NOT EXHIBITING SUPERIOR QUALITY.
7. ALL NURSERY STOCK SHALL BE GUARANTEED, BY THE CONTRACTOR, FOR ONE YEAR FROM DATE OF FINAL INSPECTION. THE GUARANTEE BEGINS ON THE DATE OF THE LANDSCAPE ARCHITECT'S OR OWNERS WRITTEN ACCEPTANCE OF THE INITIAL PLANTING. REPLACEMENT PLANT MATERIAL SHALL HAVE A ONE YEAR GUARANTEE COMMENCING UPON PLANTING.
8. PLANTS TO MEET AMERICAN STANDARD FOR NURSERY STOCK (ANSI Z60.1-2014 OR MOST CURRENT VERSION) REQUIREMENTS FOR SIZE AND TYPE SPECIFIED.
9. PRUNE PLANTS AS NECESSARY- PER STANDARD NURSERY PRACTICE AND TO CORRECT POOR BRANCHING OF EXISTING AND PROPOSED TREES.
10. TOPSOIL SHALL BE PROVIDED AND GRADED BY THE GENERAL CONTRACTOR UP TO 6 INCHES BELOW FINISHED GRADE IN TURF AREAS AND 18 INCHES IN PLANTING AREAS.
11. SEED/SOD LIMIT LINES ARE APPROXIMATE. CONTRACTOR SHALL SEED/SOD ALL AREAS WHICH ARE DISTURBED BY GRADING WITH THE SPECIFIED SEED/SOD MIXES.
12. EDGING TO BE A SPADED EDGE UNLESS INDICATED OTHERWISE ON THE PLANS. SPADED EDGE TO PROVIDE V-SHAPED DEPTH AND WIDTH TO CREATE SEPARATION BETWEEN MULCH AND GRASS. A SPADED BED EDGE SHALL SEPARATE MULCH BEDS FROM TURF OR SEEDED AREAS. A SPADED EDGE IS NOT REQUIRED ALONG CURBED EDGES.
13. CONTRACTOR SHALL INSTALL 1/2" DIAMETER DECORATIVE CA-11 ROUNDED RIVER ROCK AT 3" DEPTH OVER WEED FABRIC/BARRIER TO ALL TREES, SHRUB, PERENNIAL, AND GROUNDCOVER AREAS, UNLESS OTHERWISE INDICATED. TREES PLACED IN AREA COVERED BY TURF SHALL RECEIVE A 4 FT WIDE MAXIMUM TREE RING WITH 1/2" DIAMETER DECORATIVE CA-11 ROUNDED RIVER ROCK AT 3" DEPTH OVER WEED FABRIC/BARRIER.
14. INSTALLATION OF TREES WITHIN PARKWAYS SHALL BE COORDINATED IN THE FIELD WITH LOCATIONS OF UNDERGROUND UTILITIES. TREES SHALL NOT BE LOCATED CLOSER THAN 5' FROM UNDERGROUND UTILITY LINES AND NO CLOSER THAN 10' FROM UTILITY STRUCTURES.
15. DO NOT DISTURB THE EXISTING PAVING, LIGHTING, OR LANDSCAPING THAT EXISTS ADJACENT TO THE SITE UNLESS OTHERWISE NOTED ON PLAN.
16. ALL DISTURBED AREAS TO BE SODDED OR SEEDED, UNLESS OTHERWISE NOTED. SOD/SEED SHALL BE LOCAL HARDY TURF GRASS MIX UNLESS OTHERWISE NOTED.
17. PLANT QUANTITIES SHOWN ARE FOR THE CONVENIENCE OF THE OWNER AND JURISDICTIONAL REVIEW AGENCIES. THE CONTRACTOR IS RESPONSIBLE FOR VERIFYING ALL PLANT QUANTITIES AS DRAWN.
18. THE CONTINUED MAINTENANCE OF ALL REQUIRED LANDSCAPING SHALL BE THE RESPONSIBILITY OF THE OWNER OF THE PROPERTY ON WHICH SAID MATERIALS ARE REQUIRED. ALL PLANT MATERIALS REQUIRED BY THIS SECTION SHALL BE MAINTAINED AS LIVING VEGETATION AND SHALL BE PROMPTLY REPLACED IF THE PLANT MATERIAL HAS DIED PRIOR TO FINAL ACCEPTANCE. PLANTING AREAS SHALL BE KEPT FREE OF TRASH, LITTER, AND WEEDS AT ALL TIMES.

EXHIBIT E


NOTE: SEE CIVIL PLANS FOR FENCE INFORMATION. FINAL HEIGHT TO BE COORDINATED, AT MIN SHALL BE 6FT IN HEIGHT

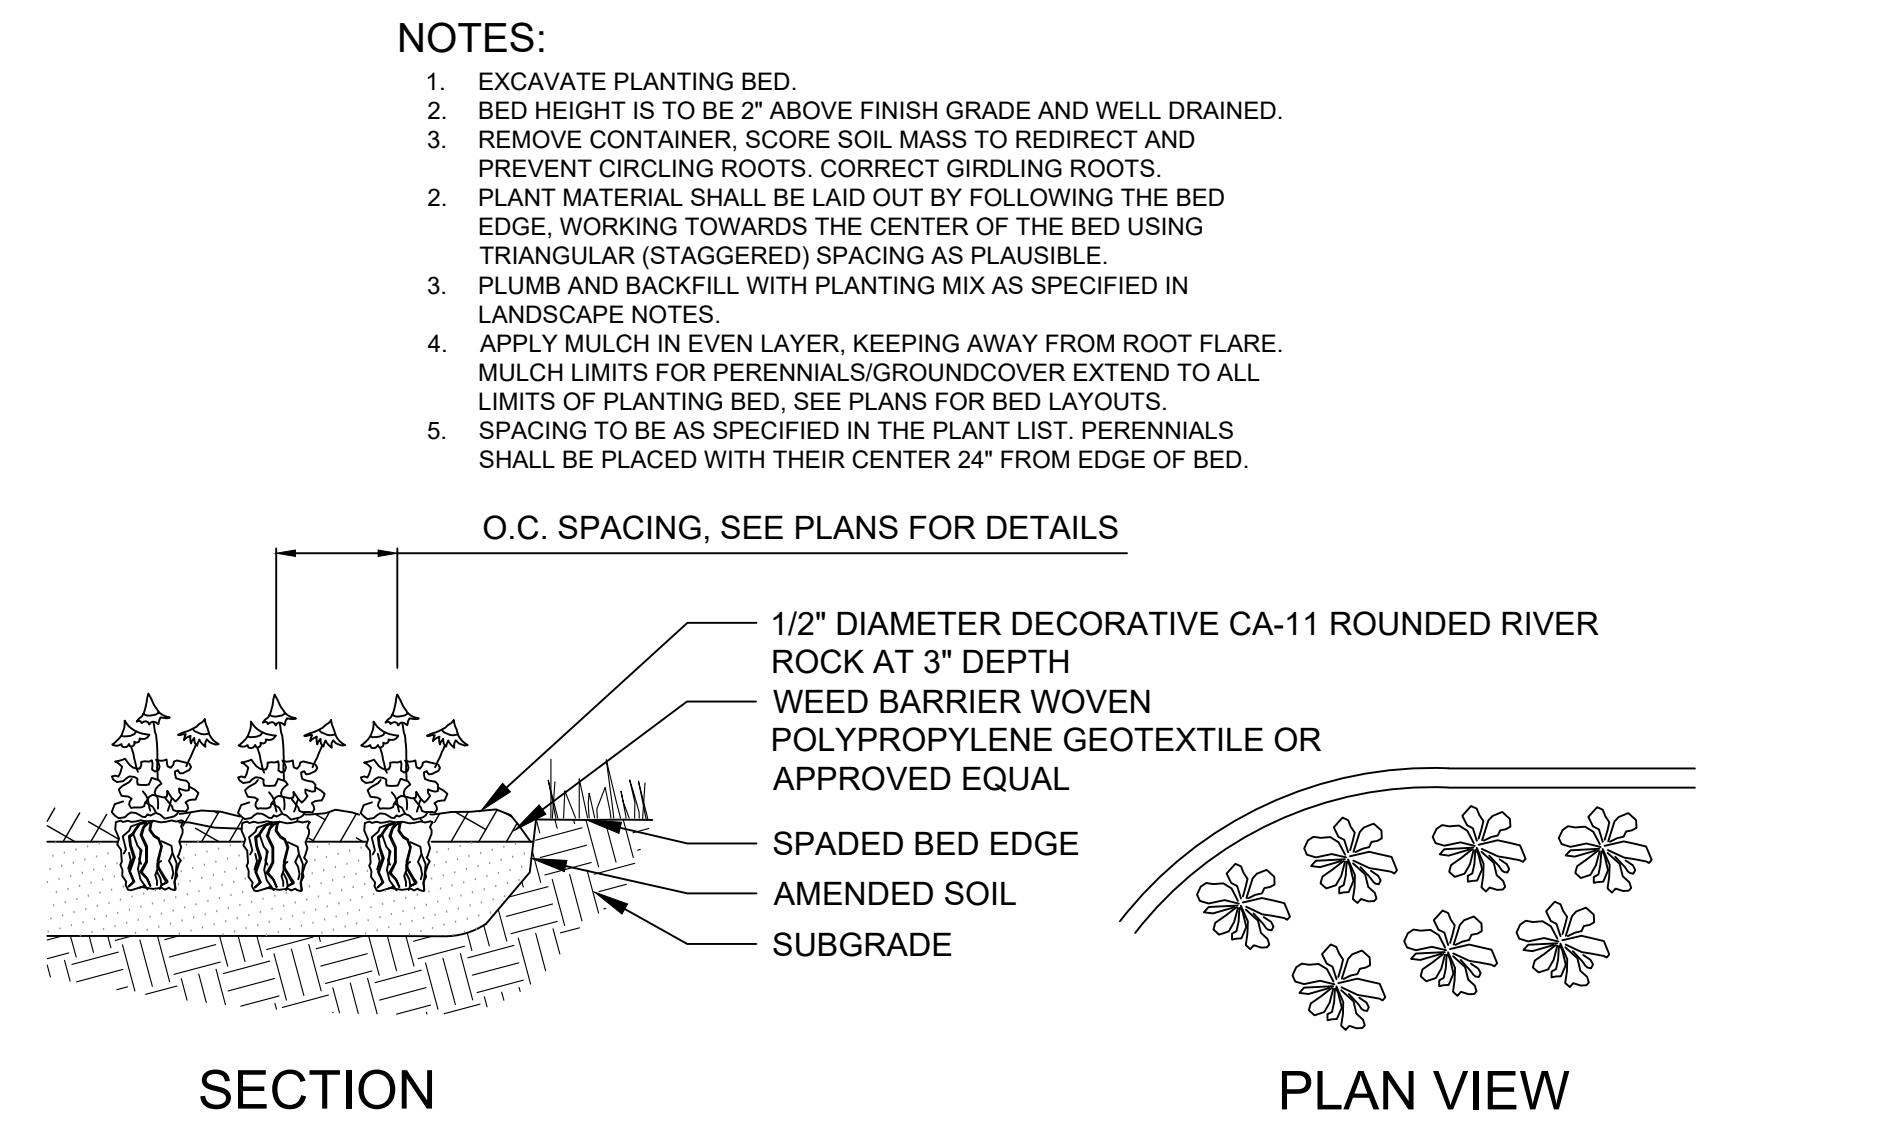

3 PERENNIAL PLANTING

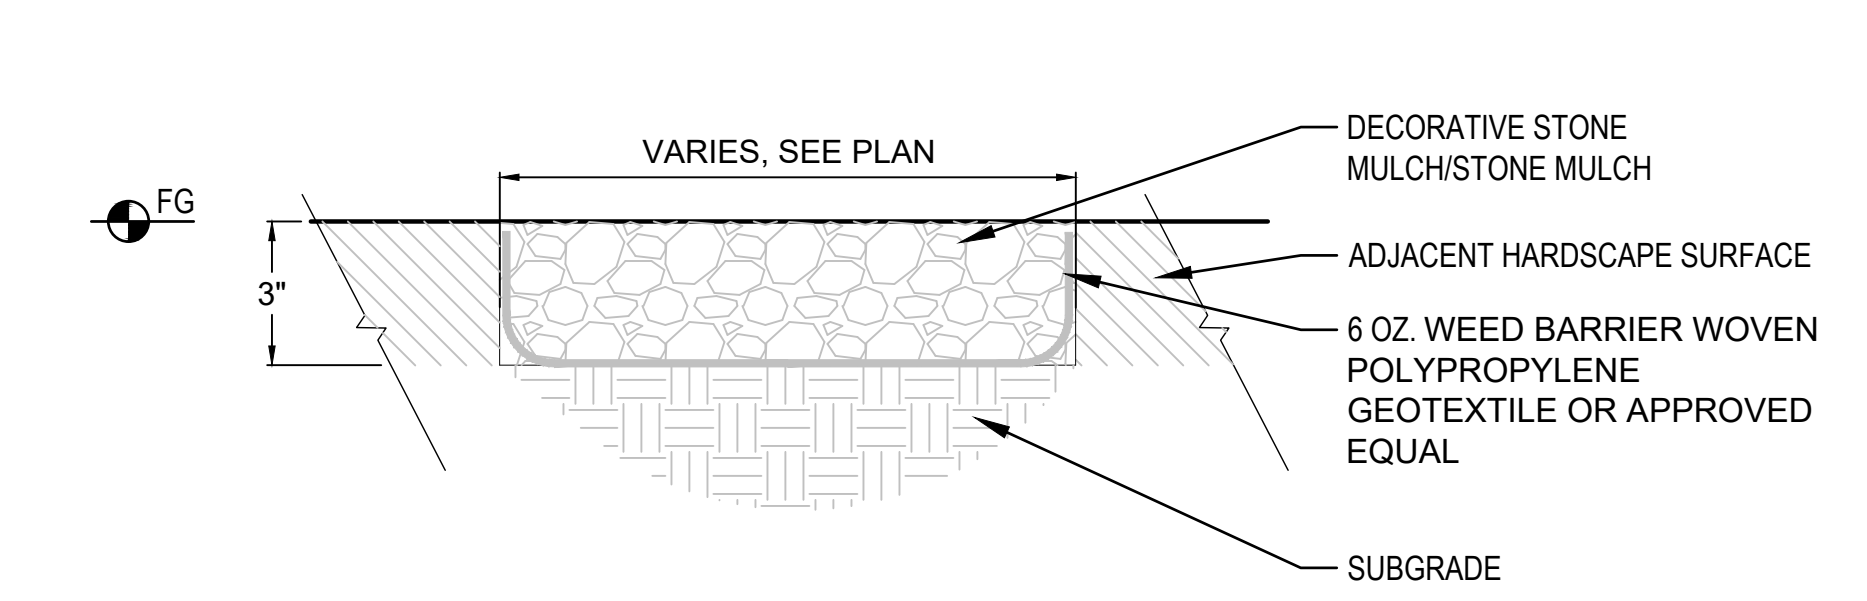

5 STONE MULCH ADJACENT TO HARDSCAPE

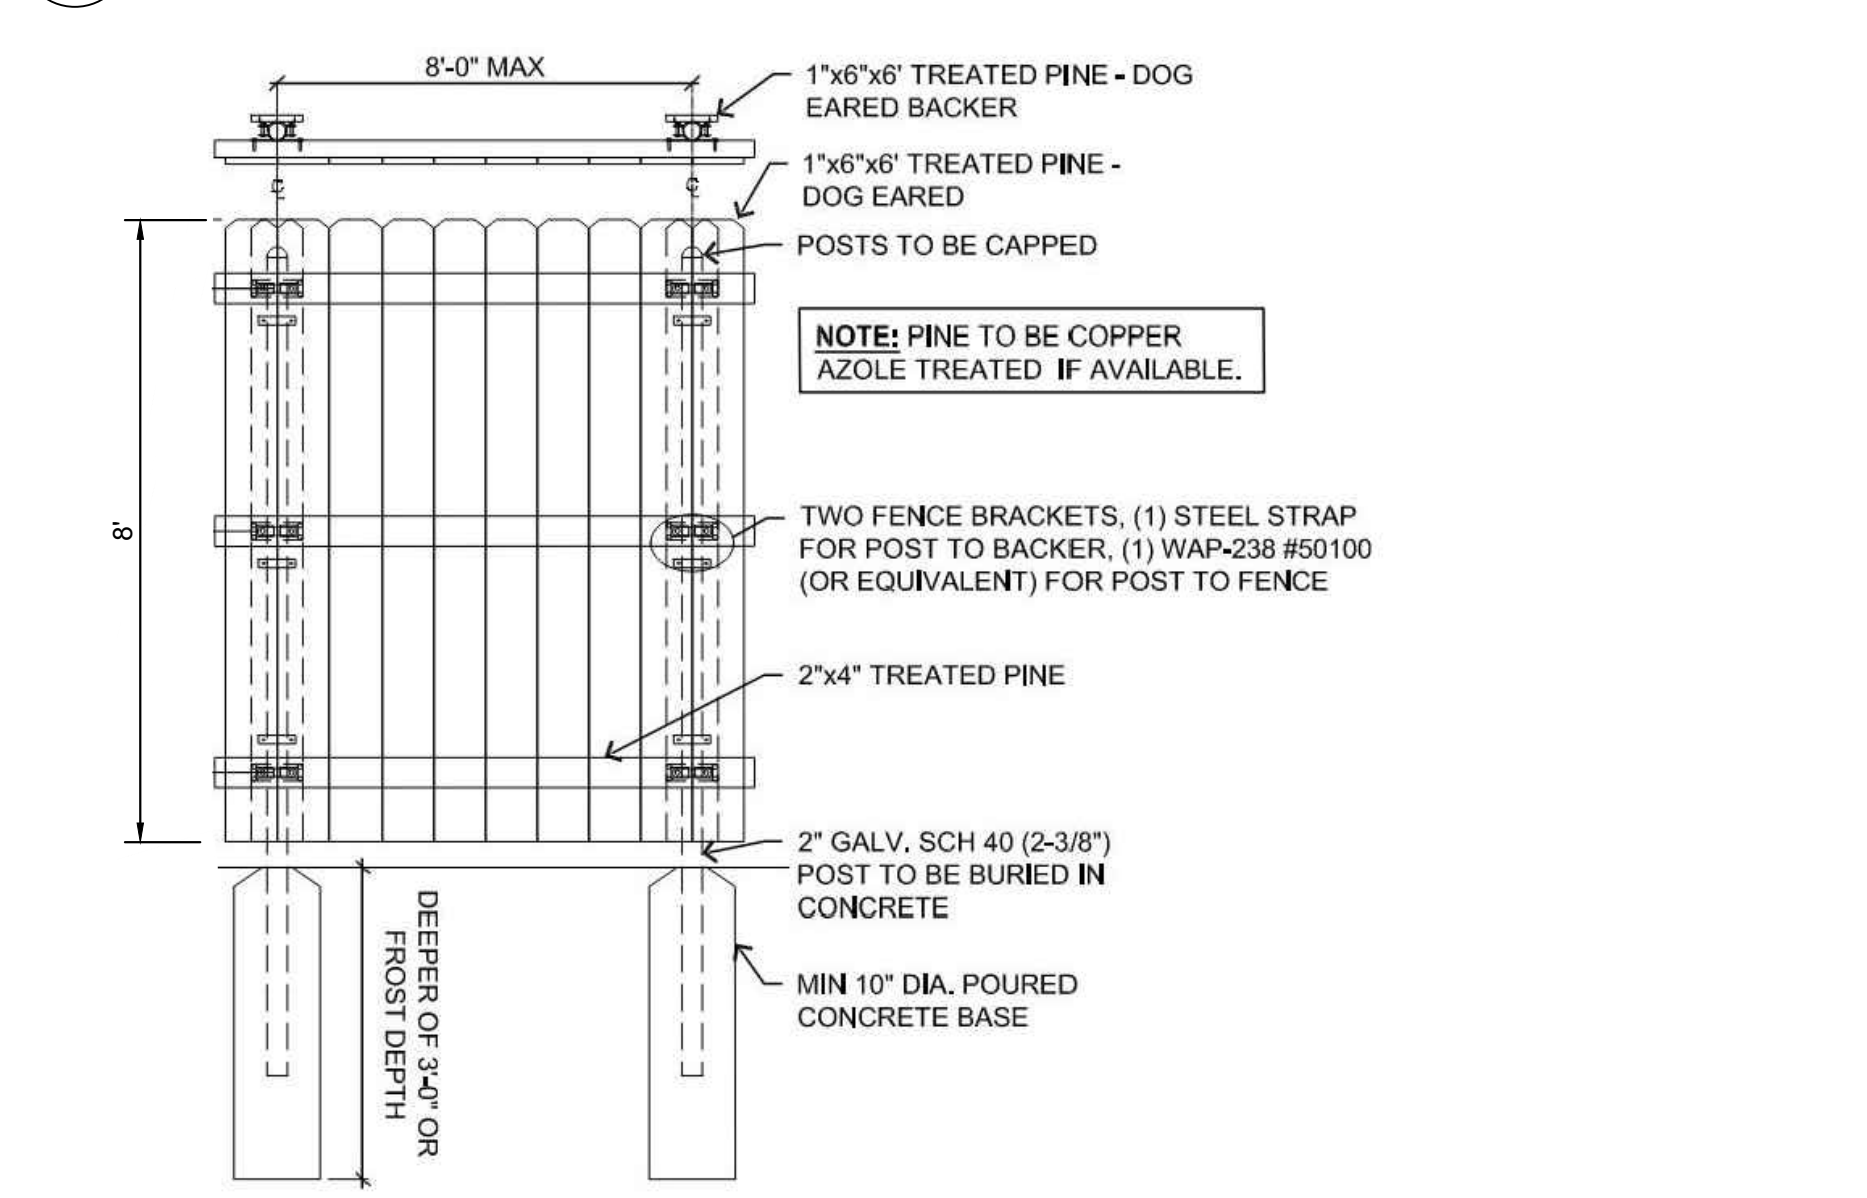

6 SCREEN/PRIVACY FENCE


IRRIGATION NOTES

1. CONTRACTOR TO DESIGN/BUILD AN IRRIGATION SYSTEM (COMPLETE-IN-PLACE) FOR ALL SOD AREAS WITH 100% HEAD TO HEAD COVERAGE.
 - 1.1. NO PART OF AN IRRIGATION SYSTEM MAY BE INSTALLED IN THE VILLAGE RIGHT-OF-WAY.
2. CONTRACTOR TO FURNISH AND INSTALL ALL LABOR AND MATERIALS REQUIRED FOR THE AUTOMATIC IRRIGATION SYSTEM TO 100% OPERATIONAL WITH NO OVERSPRAY ON ANY IMPERVIOUS AREAS, BUILDINGS/WALLS, AND/OR MONUMENT SIGNS ETC.
3. CONTRACTOR SHALL FURNISH AND INSTALL RAIN SENSOR AT THE BACK OF BUILDING ON THE RAILING, CONTRACTOR TO COORDINATE WITH OWNER/OWNER REP.
4. CONTRACTOR TO SUBMIT PRODUCT DATA AND PROPOSED LAYOUT FOR REVIEW AND APPROVAL PRIOR TO CONSTRUCTION. CONTRACTOR TO VERIFY THE AVAILABLE STATIC PRESSURE ON SITE AND NOTIFY THE OWNER/OWNER'S REPRESENTATIVE IN WRITING PRIOR TO CONSTRUCTION IF INSUFFICIENT PRESSURE IS FOUND ON SITE.
5. CONTRACTOR TO FURNISH AND INSTALL A DEDICATED IRRIGATION METER (IF ALLOWED BY THE WATER PURVEYOR) AND A DEDICATED IRRIGATION BACKFLOW PER ILLINOIS PLUMBING CODE FOR HEALTH, SAFETY, AND WELFARE. REFER TO INTERIOR ARCHITECTURAL PLUMBING PLANS FOR IRRIGATION STUBOUT.
6. CONTRACTOR TO PROVIDE ELECTRICAL 110 VOLT POWER TO THE IRRIGATION AUTOMATIC CONTROLLER. CONTRACTOR TO DETERMINE FINAL LOCATION IN THE FIELD AND COORDINATE WITH ALL RESPECTIVE TRADES FOR ELECTRICAL CIRCUITING.
7. CONTRACTOR TO FURNISH AND INSTALL WINTERIZATION AIR COMPRESSOR COUPLING CONNECTION AND PROVIDE WINTERIZATION PROCEDURES IN WRITING TO THE OWNER.
8. CONTRACTOR TO PROVIDE (2) COPIES OF A LAMINATED AS-BUILT OF THE IRRIGATION SYSTEM WITH DIMENSIONS. CONTRACTOR TO AFFIX THE AS-BUILT TO THE INTERIOR OF THE IRRIGATION CONTROLLER FOR FUTURE MAINTENANCE AND PROVIDE A COPY TO THE OWNER FOR RECORD DRAWINGS.

NOTE: CONTRACTOR TO PROVIDE DESIGN-BUILD IRRIGATION FOR THE ENTIRE SITE.

REVISED PER SITE CHANGES	07/07/25	JTA
REVISED PER CITY	05/14/25	JTA
REVISED PER CITY	04/10/25	JTA
REVISED PER IDOT & CITY	03/07/25	INS
REVISED PER CITY	11/26/24	INS
REVISIONS	DATE	BY
No.		

SCALE:	AS NOTED
DESIGNED BY:	JTA
DRAWN BY:	TVC
CHECKED BY:	INS

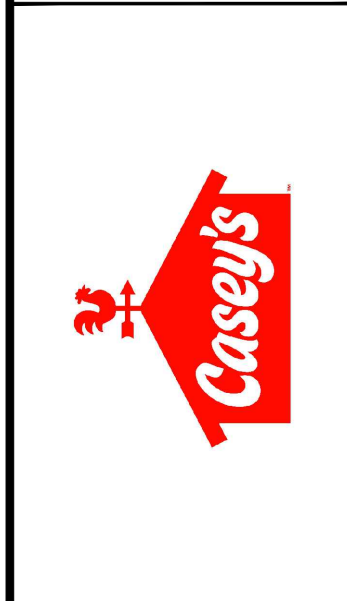

LANDSCAPE
NOTES &
DETAILS

CASEY'S
NAPERVILLE #6531

20 E. OGDEN AVE
NAPERVILLE, IL 60563

ORIGINAL ISSUE:	10/01/2024
KHA PROJECT NO.	168865042
SHEET NUMBER	

C-702