


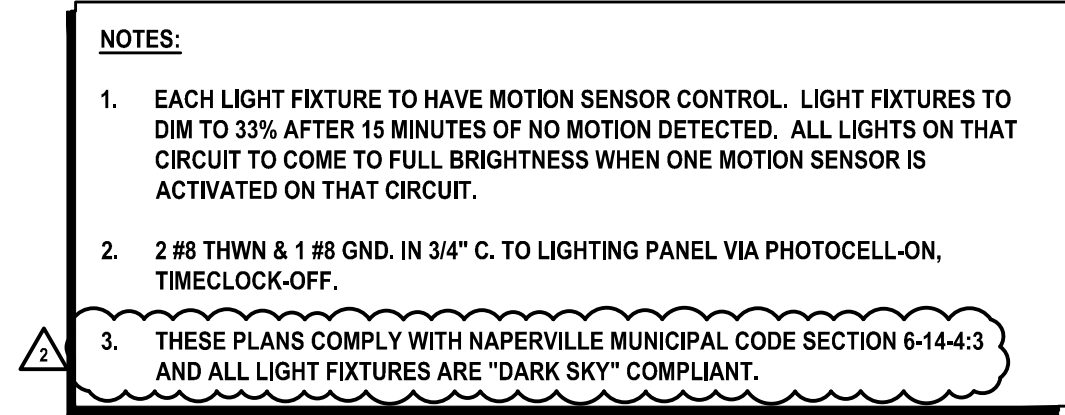

DAVID B.
KORNACKI
062.052986

STATE OF ILLINOIS

David B. Kornacki

Date: 09/22/25
Lic. Exp.: 11/30/25

JACOB & HEFNER
ASSOCIATES
1333 Butterfield Rd., Suite 300, Downers Grove, IL 60515
PHONE: (630) 652-4600, FAX: (630) 652-4601
www.jacobandhefner.com

Corporation Registration #184



KORNACKI & ASSOCIATES, INC.
Electrical Design Consultants
262-784-3323
28445 S. Moorland Rd., New Berlin, WI 53151

AS NOTED
25057IB
E1

NOTES:

1. THESE PLANS COMPLY WITH NAPERVILLE MUNICIPAL CODE SECTION 6-14-4:3 AND ALL LIGHT FIXTURES ARE "DARK SKY" COMPLIANT.

AS NOTED	 KORNACKI & ASSOCIATES, INC. Electrical Design Consultants 262-784-3323 2845 S. Moorland Rd., New Berlin, WI 53151		 JACOB & HEFNER ASSOCIATES 1333 Butterfield Rd, Suite 300, Downers Grove, IL 60515 PHONE: (630) 652-4600, FAX: (630) 652-4601 www.jacobandhefner.com	INITIAL BUILDING PHOTOMETRIC SITE PLAN						
250571B				1960 W LUCENT LANE						
E2				NAPERVILLE, ILLINOIS						
				KARIS CRITICAL						
						△ PERMIT REVIEW COMMENTS △ PERMIT REVIEW COMMENTS ISSUED FOR PERMIT	09/22/25	07/31/25	09/12/25	Date



PHOTOMETRIC SITE PLAN

SCALE: 1"=60'-0"

**LIGHTING ANALYSIS NOTES:
(NAPERVILLE REQUIREMENTS)**

1. AVERAGE FOOTCANDLES: > 0.8
2. MAXIMUM FOOTCANDLES: NA
3. MINIMUM FOOTCANDLES: > 0.2
4. MAXIMUM/MINIMUM RATIO: NA
5. AVERAGE/MINIMUM RATIO: < 4:1

LIGHTING ANALYSIS NOTES:
(PAVED AREAS ONLY)

1. AVERAGE FOOTCANDLES: 1.58
2. MAXIMUM FOOTCANDLES: 2.92
3. MINIMUM FOOTCANDLES: 0.53
4. MAXIMUM/MINIMUM RATIO: 5.5:1
5. AVERAGE/MINIMUM RATIO: 3.0:1



Date: 09/22/25
Lic. Exp.: 11/30/25

