

TOPOGRAPHIC SURVEY

PIZZUTI DEVELOPMENT
2001 BUTTERFIELD RD., STE. #440
DOWNERS GROVE, IL. 60515

<i>SHEET INDEX</i>	
SHEET 1 OF 2	BOUNDARY, EASEMENT AND SETBACK INFORMATION.
SHEET 2 OF 2	TOPOGRAPHIC INFORMATION AND LOT DETAIL.

10. DISTANCES ARE MARKED IN FEET AND DECIMAL PLACES THEREOF. NO DIMENSION SHALL BE ASSUED BY SCALE MEASUREMENT HEREON. DISTANCES AND/OR BEARINGS SHOWN IN PARENTHESES (456.67') ARE MEASUREMENTS OF DISTANCES OR BEARINGS NOT LOCATED.

11. COMPARE THIS SURVEY, BENCHMARKS AND ALL SURVEY MONUMENTS BEFORE BUILDING, AND IMMEDIATELY REPORT ANY DISCREPANCIES TO THE SURVEYOR.

12. THIS SURVEY IS SUBJECT TO MATTERS OF TITLE, WHICH MAY BE REVEALED BY A CURRENT TITLE REPORT, EASEMENTS, SETBACKS AND ENCROACHMENTS, RECORDS, RECORDS OF DEEDS, RECORDS OF REPORT, LOCAL ORDINANCES, DEEDS OR OTHER INSTRUMENTS OF RECORD THAT MAY NOT BE SHOWN.

13. ONLY THE IMPROVEMENTS WHICH WERE VISIBLE FROM ABOVE, GROUND SURVEY, INCLUDING BUT NOT LIMITED TO, NORMAL SEARCH AND WALK THROUGH OF THE SITE ARE SHOWN ON THE FACE OF THIS PLAN. LAWN SPRINKLER SYSTEMS, IF ANY, ARE NOT SHOWN ON THIS SURVEY.

14. THIS SURVEY MAY NOT REFLECT ALL UTILITIES, OR IMPROVEMENTS, IF ANY, WHICH ARE NOT VISIBLE FROM ABOVE, GROUND SURVEY, OR OTHER OBSTRUCTIONS. THERE MAY BE ADDITIONAL UTILITIES OR IMPROVEMENTS THAT HAVE NOT BEEN SHOWN.

15. UNDERGROUND UTILITIES INCLUDING, BUT NOT LIMITED TO, STORM AND SANITARY SEWERS, WATER MAINS, TELEPHONE AND ELECTRIC CABLES OR FIBER OPTIC CABLES, AND OTHER UTILITIES, LINES SHOWN HEREON ARE BASED ON THE FOLLOWING: ACTUAL OBSERVED LOCATION AT AN OPEN EXCAVATION, RECORDS OF DEEDS, RECORDS OF RECORDS OF DEEDS, PROPOSED UTILITY UTILITIES FROM PRIVATE UTILITY COMPANIES AND/OR LOCAL MUNICIPALITIES. THE EXACT LOCATION MAY BE DIFFERENT FROM THE LOCATION SHOWN HEREON.

16. OTHER THAN VISIBLE OBSERVATIONS NOTED HEREON, THIS SURVEY IS BASED ON THE PRESENCE OR ABSENCE OF ANY SERVICE OR UTILITY LINE. CONTROLLED UNDERGROUND EXPLORATORY EFFORT TOGETHER WITH "JULIE" MARKINGS IS REQUIRED TO DETERMINE THE FULL EXTENT OF UNDERGROUND SERVICE AND UTILITY LINES. CONTACT JULIE... AT 1-800-992-0123.

17. THIS SURVEY WAS PREPARED FOR PIZZUTI DEVELOPMENT BASED ON A FIELD SURVEY COMPLETED ON MAY 2, 2016. BOUNDARY LINES SHOWN ON THIS SURVEY WERE DETERMINED BY A FIELD SURVEY PREPARED BY COMPASS SURVEYING, LTD. DATED APRIL 26, 2016.

18. WETLAND AREAS SHOWN HEREON WERE DELINEATED BY GARY R. WEBER ASSOCIATES DATED MAY 3, 2016.


19. THIS PROFESSIONAL SERVICE CONFORMS TO THE CURRENT ILLINOIS MINIMUM STANDARDS FOR A TOPOGRAPHIC SURVEY. MANHOLE COORDINATES AND ELEVATIONS ARE BASED ON THE ILLINOIS FIRM REGISTRATION NUMBER 1840003350, EXPIRES APRIL 30, 2017.

LOT 1 IN THE FINAL PLAT OF SUBDIVISION FOR MCDOWELL POINT, BEING A SUBDIVISION OF PART OF THE SOUTH HALF OF SECTION 3, TOWNSHIP 38 NORTH, RANGE 9 EAST OF THE THIRD PRINCIPAL MERIDIAN, ACCORDING TO THE PLAT THEREOF RECORDED SEPTEMBER 22, 2008 AS DOCUMENT R2008-143214, IN DUPAGE COUNTY, ILLINOIS.



LOCATION MAP

NOT TO SCALE

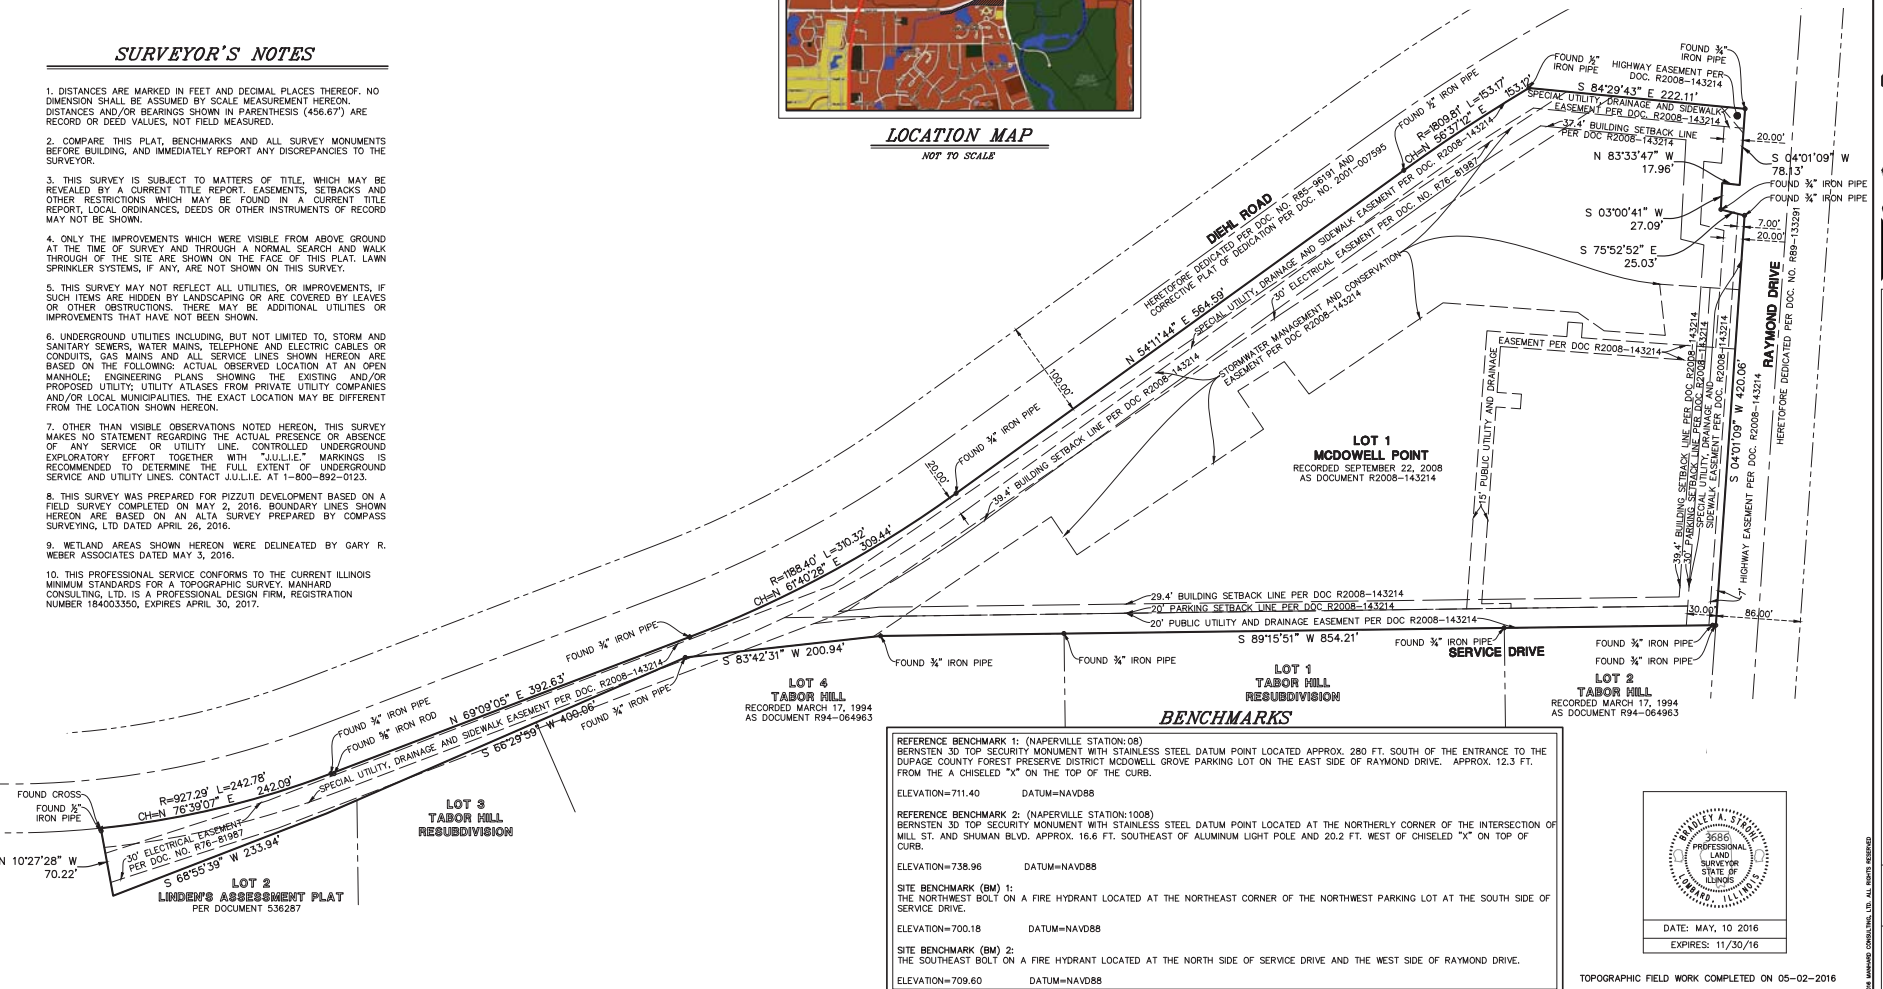

TOPOGRAPHIC FIELD WORK COMPLETED ON 05-02-2016

Manhard
CONSULTING LTD

MCDOWELL POINT DEVELOPMENT
VACANT LAND - RAYMOND DR. & DIEHL RD., NAPERVILLE
TOPOGRAPHIC SURVEY

PROJ MGR.: BAS
PROJ ASSOC.: CNB
DRAWN BY: CNB
DATE: 05-11-16
SCALE: 1"=60'

SHEET
1 OF **2**
PZDNVIL01