




- PLAN NOTES :**
- For Plant Material List see Sheet L.101
 - For Seed Mixes & Turf see sheet L.102
 - For Naturalized Basin see sheet L.102
 - For Construction Notes & Details see sheet L.101
 - For Wagner Farm landscaping shown see Final Landscape Plans prepared by Signature Design Group, and dated 4.01.2019 (revision 2)

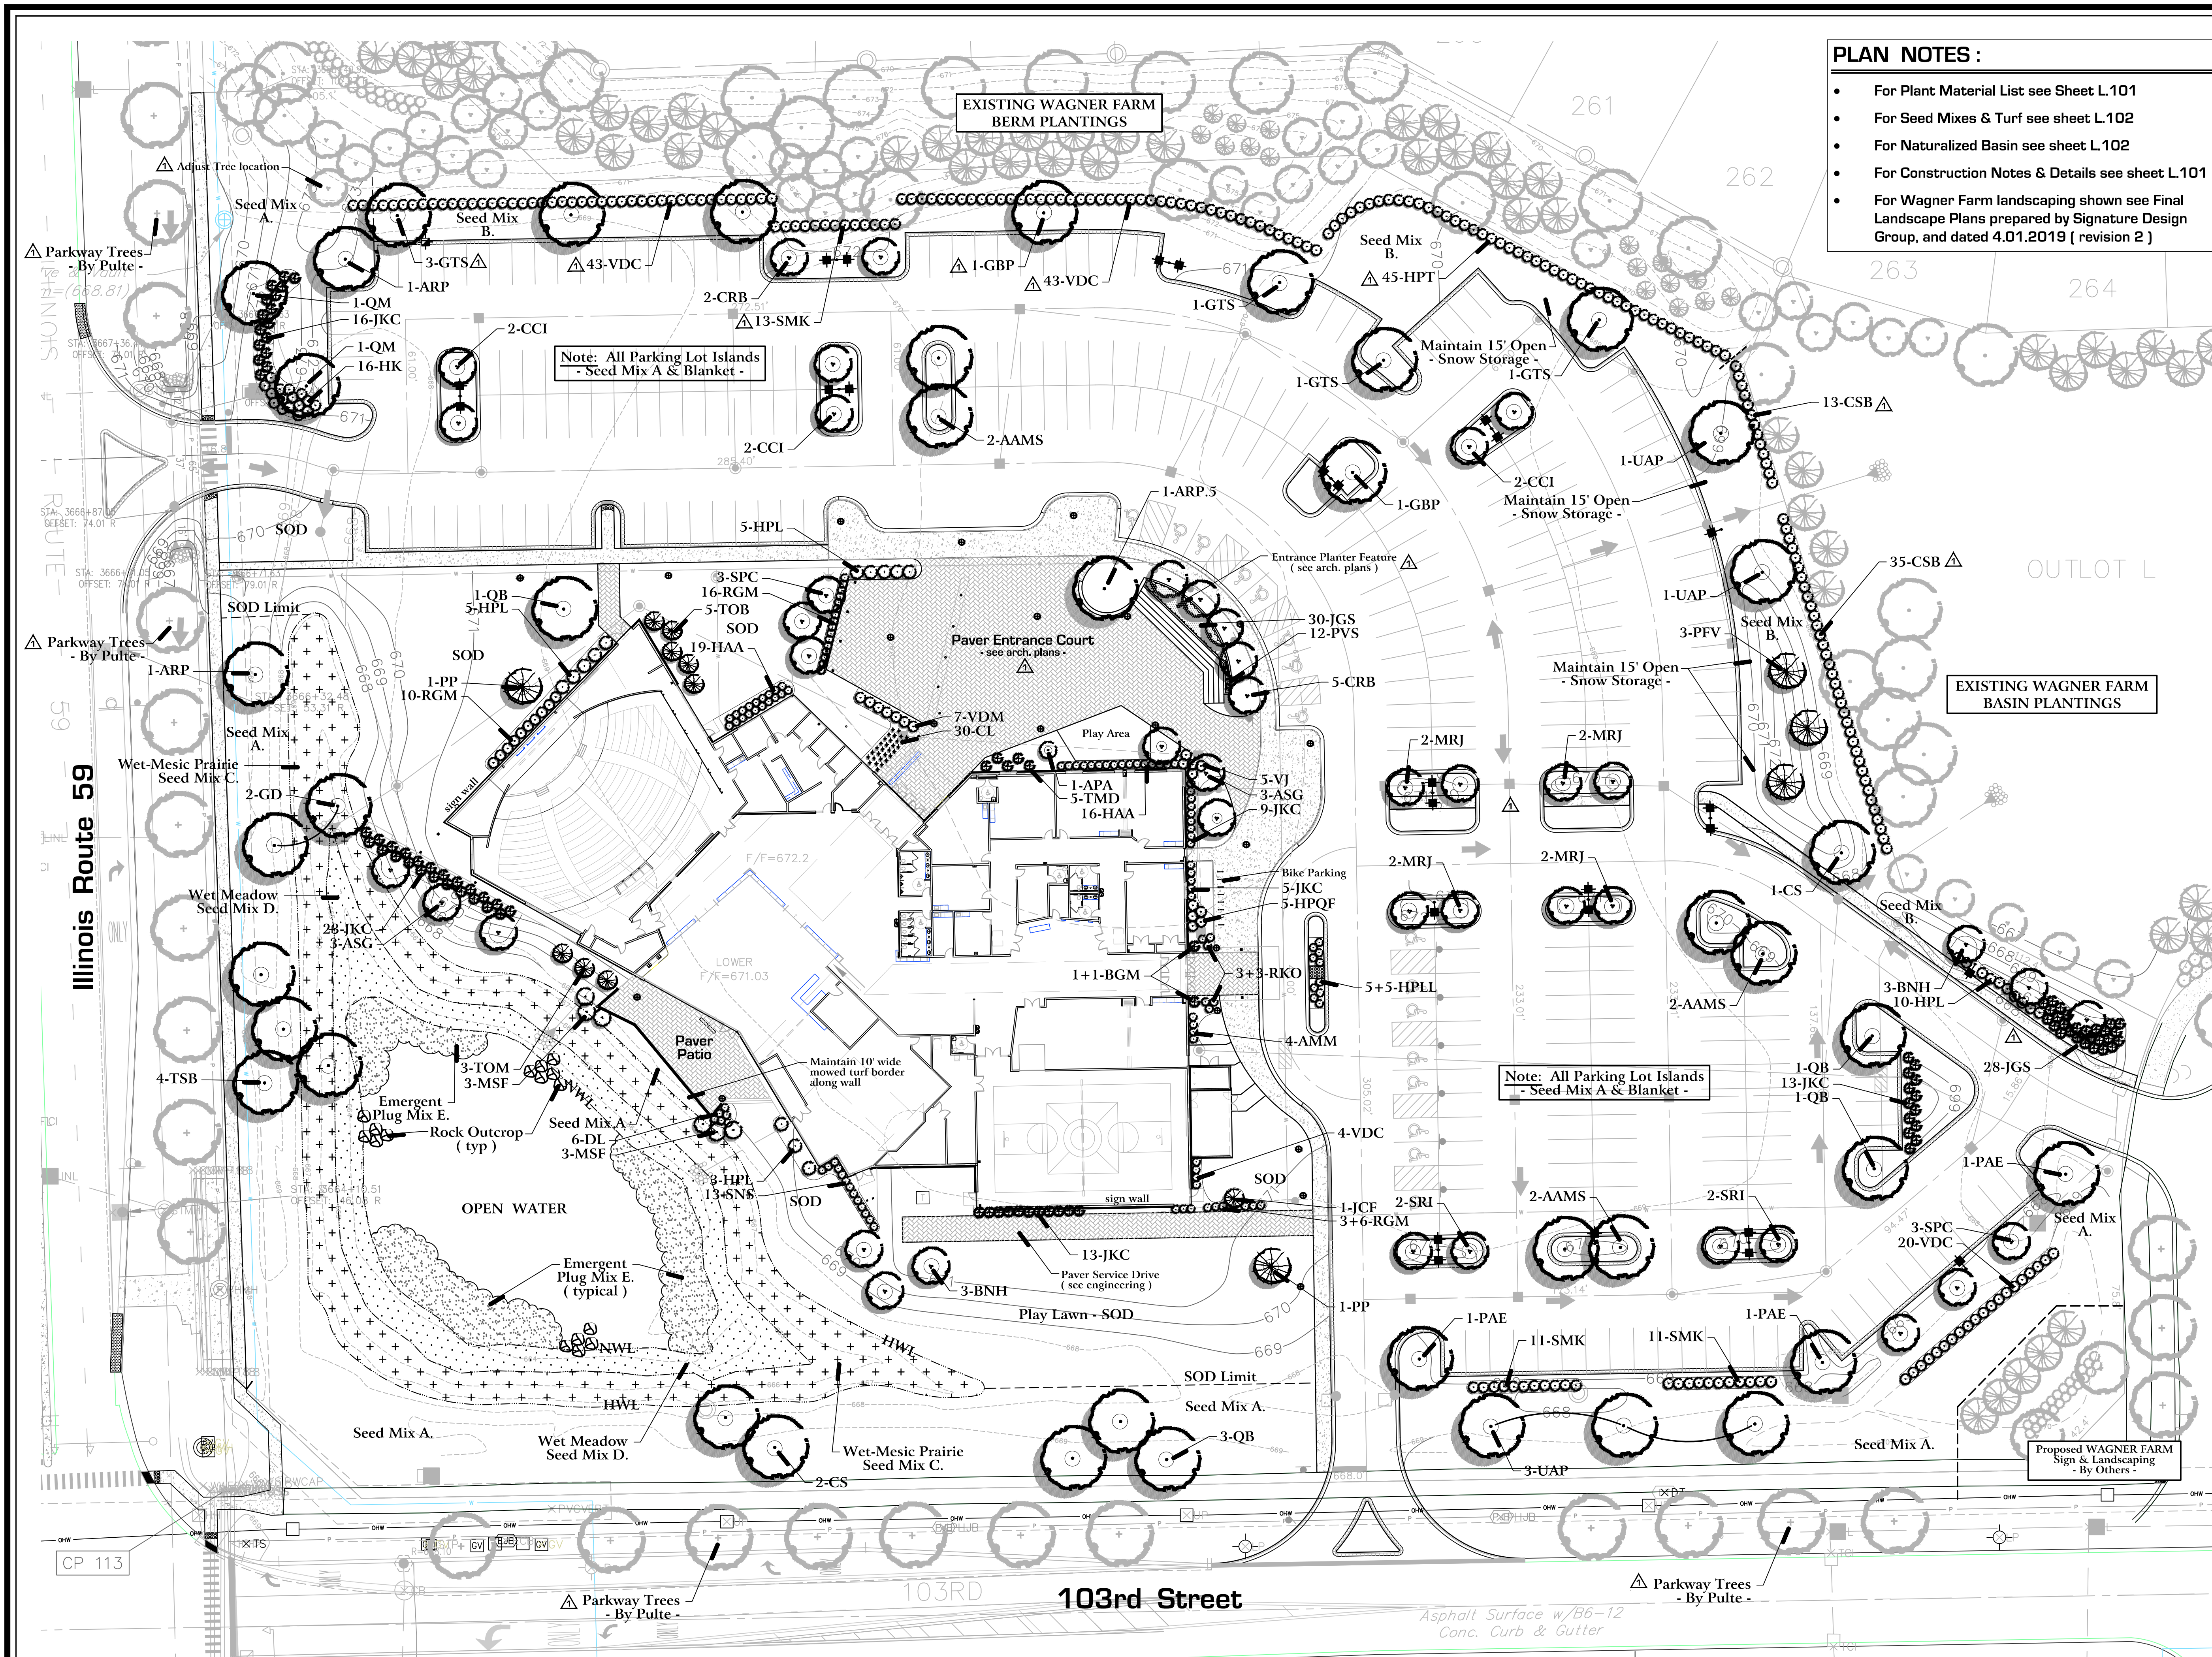

Land Planning
Landscape Architecture
Environmental Site Design

132 N. WASHINGTON ST. - NAPERVILLE, IL 60540 -- 630.305.3980 Fax 630.305.3994

project:

The
Compass Church
South Naperville Campus

103rd St. & Route 59
Naperville, Illinois

sheet description:


Final
Landscape Plan

client:

Glenn H. Johnson Construction
1776 Winthrop Drive
Des Plaines, IL 60018



north: scale: 1" = 30'0"

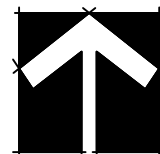

revisions: 3.4.2020 Per City Review Comments dated 2.26.2020

original issue date: 3 February 2020

drawn by:

checked by:

project no.: 29028

sheet no.:

Site Plan : Architectural Site Plan as provided by Pasma Group Architects, and undated.
Engineering Base Sheet as provided by CEMCON, Ltd and dated 1.17.2020.