EXHIBIT B

EXACTA
LAND SURVEYORS, LLC

FIELD WORK DATE: 5/22/2020 **REVISION DATES:** (REV.0 5/28/2020)

PROPERTY ADDRESS	SURVEY NUMBER
214 N LAIRD STREET, NAPERVILLE, ILLINOIS 60540	2005.5019

PROPERTY PICTURE

GOOGLE MAP

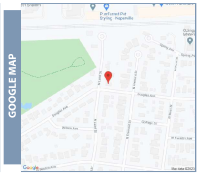

TRANSACTION

CLIENT ORDER NUMBER: DATE: 05/28/20

BUYER:

SELLER:

CERTIFIED TO:

.

LEGAL DESCRIPTION

LOT 36 IN LAIRD'S ADDITION TO NAPERVILLE, BEING A SUBDIVISION IN THE WEST 1/2 OF SECTION 13, TOWNSHIP 38 NORTH, RANGE 9, EAST OF THE THIRD PRINCIPAL MERIDIAN, ACCORDING TO THE PLAT THEREOF RECORDED OCTOBER 10, 1928 AS DOCUMENT 267356, IN DUPAGE COUNTY, ILLINOIS.

POINTS OF INTEREST

FLOOD INFORMATION

JOB SPECIFIC SURVEYOR NOTES

2005.5019
BOUNDARY SURVEY
DUPAGE COUNTY

LOT 36 IN LAIRD'S ADDITION TO NAPERVILLE, BEING A SUBDIVISION IN THE WEST 1/2 OF SECTION 13, TOWNSHIP 38 NORTH, RANGE 9, EAST OF THE THIRD PRINCIPAL MERIDIAN, ACCORDING TO THE PLAT THEREOF RECORDED OCTOBER 10, 1928 AS DOCUMENT 267356, IN DUPAGE COUNTY, ILLINOIS.

POINTS OF INTEREST:

1. RESIDENCE OVER BUILDING LINE

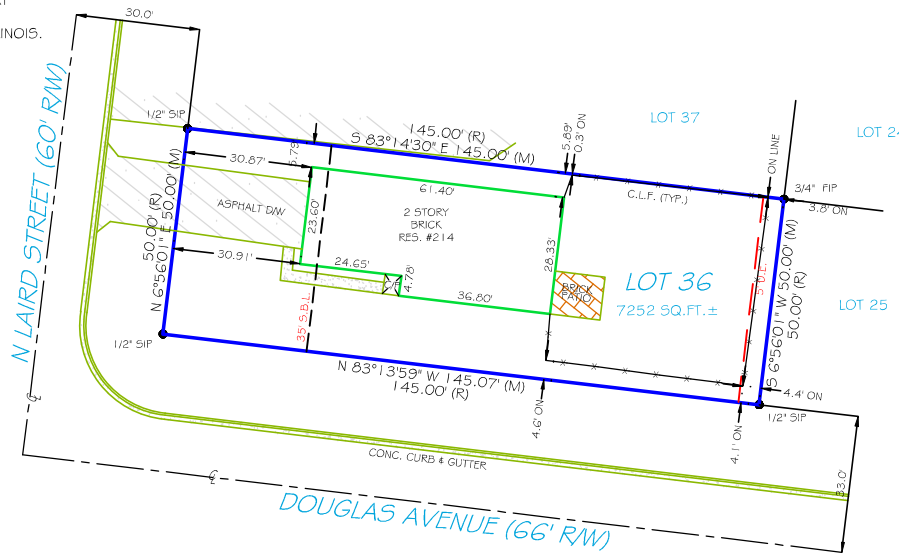

STATE OF ILLINOIS } SS
COUNTY OF LaSALLE }

THIS IS TO CERTIFY THAT THIS PROFESSIONAL SERVICE CONFORMS TO THE CURRENT ILLINOIS MINIMUM STANDARDS FOR A BOUNDARY SURVEY. GIVEN UNDER MY HAND AND SEAL THIS 26TH DAY OF MAY, 2020 AT 1568 HOLIDAY DRIVE, SANDWICH, IL 60548.

WARREN D. JOHNSON
035-002971
PROFESSIONAL LAND SURVEYOR
SANDWICH, IL
STATE OF ILLINOIS

ILLINOIS PROFESSIONAL LAND SURVEYOR No. 2971
LICENSE EXPIRES 11/30/2020
EXACTA LAND SURVEYORS
PROFESSIONAL DESIGN FIRM 184008059-0008

30 0 15 30
GRAPHIC SCALE (In Feet)
1 inch = 30' ft.

SURVEYOR'S LEGEND

(C)	CALCULATED
(D)	DEED
(F)	FIELD
(M)	MEASURED
(P)	PLAT
(R)	RECORDED
(S)	SURVEY
A.B.B.L.	ACCESSORY SETBACK LINE
A/C	AIR CONDITIONING
B.C.	BLOCK CORNER
B.F.P.	BACKFLOW PREVENTER
B.R.	BEARING REFERENCE
B.R.L.	BUILDING RESTRICTION LINE
B/W	BAYWOOD WINDOW
BLDG.	BUILDING
BLK.	BLOCK
BM	BENCHMARK
BSMT.	BASEMENT
C	CENTER
C.B.	CONCRETE BLOCK
C.L.F.	CHAIN LINK FENCE
C.O.	CLEAN OUT
C.V.G.	CONCRETE VALLEY GUTTER
CL	CENTER LINE
C/P	COVERED PORCH
C/S	CONCRETE SLAB
CATV	CABLE TV RISER
CH.	CHORD BEARING
CONC.	CONCRETE
CPAC.	CPAC METER
CR.	CROCK
CS/W	CONCRETE SIDEWALK
D/F	DRAIN FIELD
D.H.	DRILL HOLE
D/W	DRIVEWAY
E.O.W.	EDGE OF WATER
ELEV.	ELEVATION
EM	ELECTRIC METER
ENCL.	ENCLOSURE
ENT.	ENTRANCE
E/UB	ELECTRIC UTILITY BOX
F.F.	FINISHED FLOOR
F.O.P.	EDGE OF PAVEMENT
F/DH	FOUND DRILL HOLE
FCM	FND. CONCRETE MONUMENT
F/P	FOUND IRON PIPE
F/PC	FOUND IRON PIPE & CAP
F/R	FOUND IRON ROD
F/RC	FOUND IRON ROD & CAP
FN	FOUND NAIL
F/N&D	FOUND NAIL AND DISC
F/PK	FOUND PK
F/P/K	FOUND PARKER-KALON NAIL
F/PK&D	FOUND PK NAIL & DISC
F/RR SPK	FOUND RAILROAD SPIKE
GAR.	GARAGE
GM	GAS METER
I/D	IDENTIFICATION
ILL.	ILLEGIBLE
INST.	INSTRUMENT
INT.	INTERSECTION
L	LENGTH
LIC#	LICENSE # - BUSINESS
LIC#	LICENSE # - SURVEYOR
M.B.	MAP BOOK
M.E.S.	MITERED END SECTION
M.F.	METAL FENCE
MES	MITERED END SECTION
MH	MANHOLE
N.R.	NON RADIAL
N.T.S.	NOT TO SCALE
NAVD88	NORTH AMERICAN VERTICAL DATUM OF 1988
NGVD29	NATIONAL GEODETIC VERTICAL DATUM OF 1929
O.G.S.	ON GRADE STAKE
O.G.	ON GROUND
O.R.B.	OFFICIAL RECORD BOOK
O.R.V.	OFFICIAL RECORD VOLUME
O/A	OVERALL
O/S	OFFSET
OFF	OUTSIDE OF SUBJECT PARCEL
OH.	OVERHANG
OHL	OVERHEAD LINES
ON	INSIDE OF SUBJECT PARCEL
P.O.	POINT OF
P.C.	POINT OF CURVATURE
P.C.C.	POINT OF COMPOUND CURVATURE
P.C.P.	PERMANENT CONTROL POINT
PI.	POINT OF INTERSECTION
P.O.B.	POINT OF BEGINNING
P.O.C.	POINT OF COMMENCEMENT
P/P.	PINCHED PIPE
P.R.C.	POINT OF REVERSE CURVATURE
P.R.M.	PERMANENT REFERENCE MONUMENT
P.T.	POINT OF TANGENCY
P/E	POOL EQUIPMENT
P.P.	POWER POLE
P.L.S.	PROFESSIONAL LAND SURVEYOR
PLT	PLANTER
P.S.M.	PROFESSIONAL SURVEYOR AND MAPPER
R	RADIUS or RADIAL
R.P.	RADIUS POINT
R/W	RIGHT OF WAY
RES.	RESIDENCE
R/R	RANGE
S.B.L.	SET BACK LINE
S.E.L.	SURVEY EASEMENT LINE
S.T.L.	SURVEY TIE LINE
S.W.	SIDEWALK
S/GD	SET GLUE DISC
S/W	SIDEWALK
SCR.	SCREEN
SEC.	SECTION
SEP.	SEPTIC TANK
SEW.	SEWER
S/IRC	SET IRON ROD & CAP
S/N&D	SET NAIL & DISC
SQ.F.T.	SQUARE FEET
STY.	STORY
SV	SEWER VALVE
T.O.B.	TOP OF BANK
TBM	TEMPORARY BENCHMARK
TEL.	TELEPHONE FACILITIES
TWP.	TOWNSHIP
TX	TRANSFORMER
TYP.	TYPICAL
U.R.	UTILITY RISER
UG	UNDERGROUND
UR	UTILITY RISER
V.C.	VINYL CORNER
W.F.	WOODEN FENCE
W/C	WITNESS CORNER
W/F	WATER FILTER
WM	WATER METER/VALVE BOX
WV	WATER VALVE
A.E.	ACCESS EASEMENT
AN.E.	ANCHOR EASEMENT
C.M.E.	CANAL MAINTENANCE ESMT.
C.U.E.	COUNTY UTILITY ESMT.
D.E.	DRAINAGE EASEMENT
D.U.E.	DRAINAGE AND UTILITY ESMT.
E.E.	ENTRY ESMT.
I.E.R.E.	INGRESS/EGRESS ESMT.
IRR.E.	IRRIGATION EASEMENT
L.A.E.	LIMITED ACCESS ESMT.
L.B.E.	LANDSCAPE BUFFER ESMT.
L.E.	LANDSCAPE ESMT.
L.M.E.	LAKE OR LANDSCAPE MAINTENANCE EASEMENT
M.E.	MAINTENANCE EASEMENT
P.U.E.	PUBLIC UTILITY EASEMENT
R.O.E.	ROOF OVERHANG ESMT.
S.W.E.	SIDEWALK EASEMENT
S.W.M.E.	STORM WATER MANAGEMENT EASEMENT
T.U.E.	TECHNOLOGICAL UTILITY ESMT.
U.E.	UTILITY EASEMENT

Use of this Survey other than Intended, without Writen Verification, will be at the User's Sole Risk and without Liability to the Surveyor. Nothing hereon shall be Construed to give ANY Rights or Benefits to Anyone than those Certified

THANKS TO

Exacta Proudly Supports
THE cara PROGRAM
transforming lives...
www.thecaraprogram.org
Since 1991, The Cara Program has placed more than 4,800 motivated adults into more than 6,600 quality jobs, catalyzing the same number of families to stop the transfer of poverty from one generation to the next.

GENERAL SURVEYOR NOTES

1. The legal description used to perform this survey was supplied by others. The survey does not determine or imply ownership.
2. This survey only shows improvements found above ground. Underground footings, utilities, and improvements were not located on this survey map.
3. If there is a septic tank, well or drain tile on the survey, the location of such items was shown to us by others and are not verified.
4. This survey is exclusively for the use of the parties to whom it is certified.
5. Any additions or deletions to this 3-page survey document are strictly prohibited.
6. Dimensions are in feet and decimals thereof.
7. Due to varying construction standards, house dimensions are approximate.
8. Any FEMA flood zone data contained in this survey is for informational purposes only. Research to obtain such data was performed at www.fema.gov.
9. All pins marked as set are 5/8 diameter, 18" iron rebar.
10. Unless specifically stated otherwise, an examination of the abstract of title was not performed by the signing surveyor to determine which instruments, if any, are affecting this property.
11. Points of Interest (POI's) are selected above-ground improvements which may be in conflict with boundary, building setback, or easement lines, as defined by the parameters of this survey. There may be additional POI's which are not shown, not called out as POI's, or which are otherwise unknown to the surveyor. These POI's may not represent all items of interest to the viewer.
12. Utilities shown on the subject property may or may not indicate the existence of recorded or unrecorded utility easements.
13. The information contained in this survey has been performed exclusively and is the sole responsibility of Exacta Land Surveyors, LLC. Additional logos or references to third party firms are for informational purposes only.
14. Noise measurements should not be used for new construction or planning. Measurements should be verified prior to such activity.
15. Surveyor bearings are used for angular reference and are used to show angular relationships of lines only and are not intended or represented to true an magnetic north. Bearing as-are shown as surveyor bearings, and where shown as matching those on the subdivision plat/s as called this survey is based, they are to be deemed as more accurate as the determination of a north orientation made on and for those original subdivision plats. North 0 degrees east is assumed and upon preparation of this plat, the resulting bearing between found points as shown on this survey is the basis of said surveyor bearings as defined and required to be noted by Illinois Administrative Code Title 68, Chapter VI, Sub-Chapter B, Part 1270, Section 1270.56, Paragraph B, Sub-Paragraph B, Item 6.

PERFORMED BY

EXACTA
LAND SURVEYORS, LLC
LB# 184008059
316 East Jackson Street, Morris, IL 60450
Phone: 773.305.4011