NOTE: DETAILED LANDSCAPE DESIGN TO BE PROVIDED AT TIME OF INDIVIDUAL SITE PLAN REVIEW AND APPROVAL.

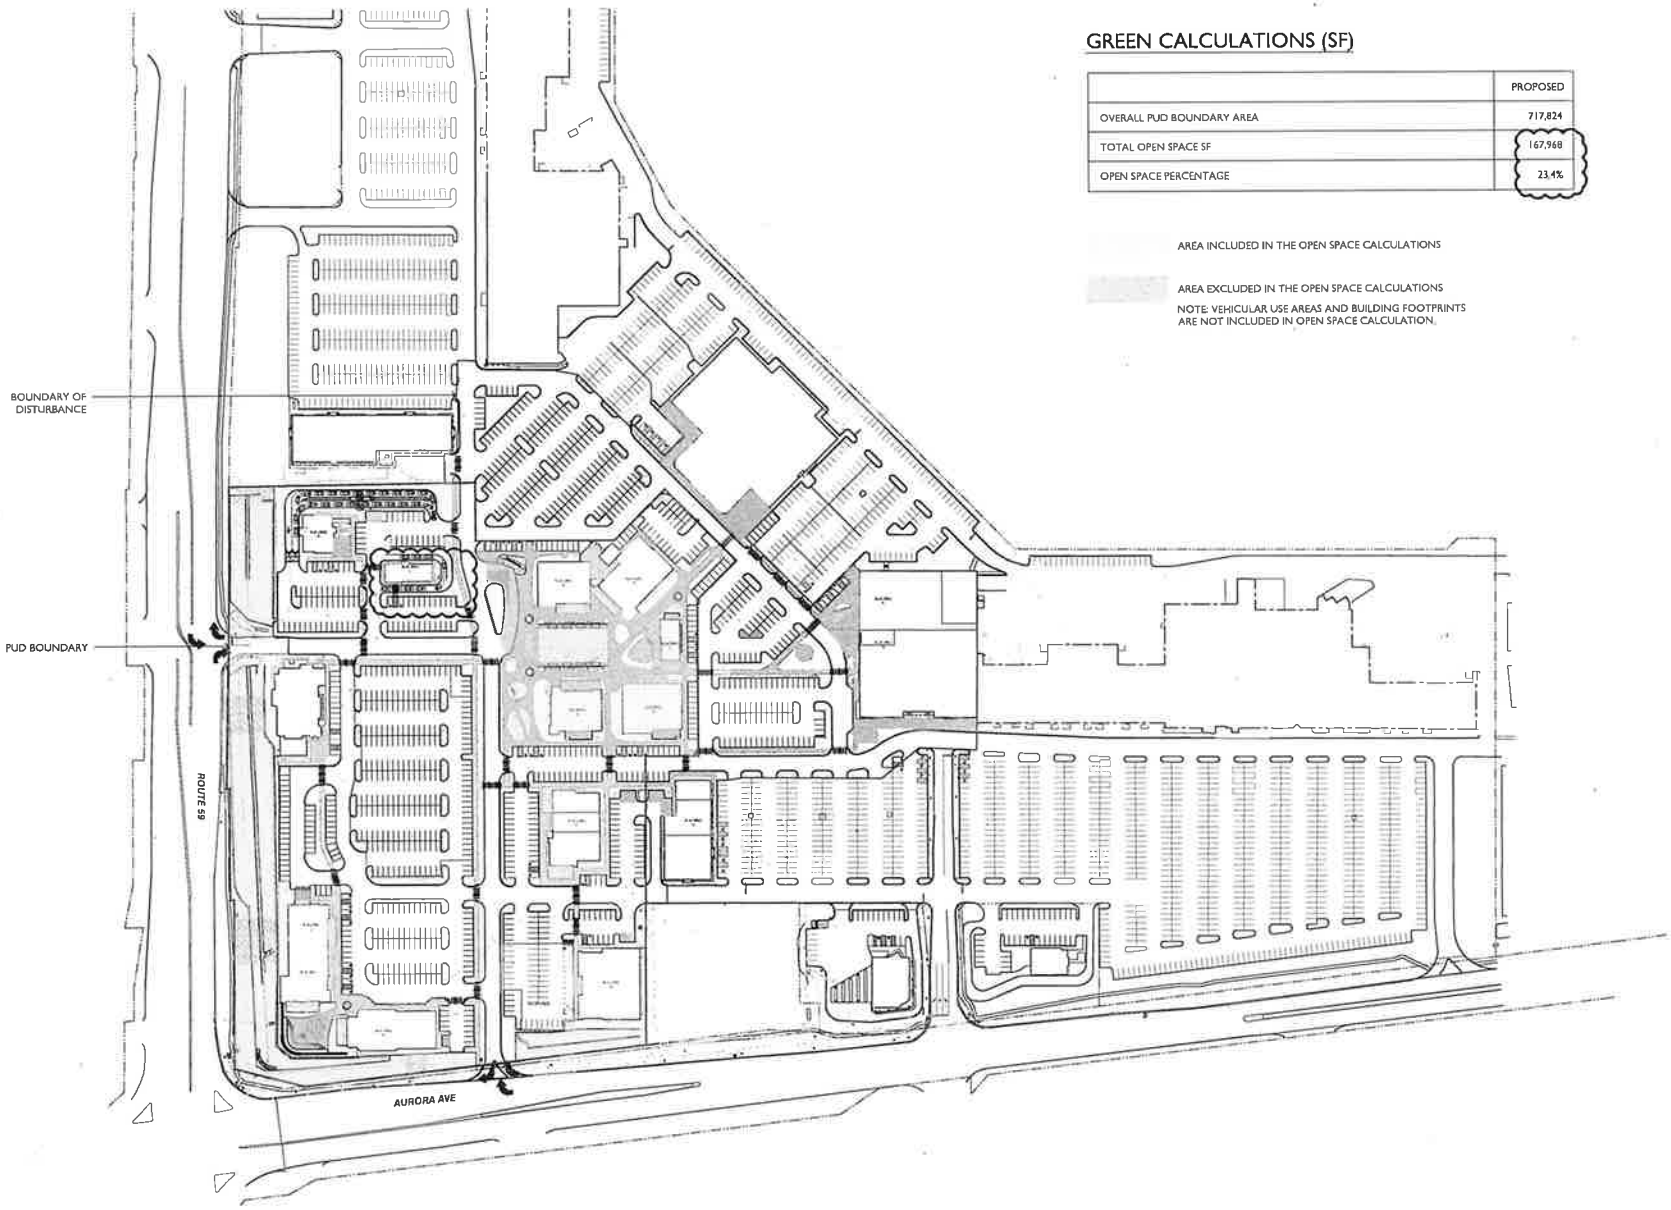

GREEN CALCULATIONS (SF)

	PROPOSED
OVERALL PUD BOUNDARY AREA	717,824
TOTAL OPEN SPACE SF	167,968
OPEN SPACE PERCENTAGE	23.4%

AREA INCLUDED IN THE OPEN SPACE CALCULATIONS

AREA EXCLUDED IN THE OPEN SPACE CALCULATIONS

NOTE: VEHICULAR USE AREAS AND BUILDING FOOTPRINTS ARE NOT INCLUDED IN OPEN SPACE CALCULATION.

OVERALL SITE PLAN
SCALE: 1"=100'

NELSON

Client

Landscape Architect

MEP Engineer

Structural Engineer

Civil

Legal

Environmental Graphics

BRIXMOR Property Group

Block 59
404 S. State Route 59
Naperville, IL 60540

GREEN CALCULATION

L-002

EXHIBIT I